




Access Compliance Report Public Rights-of-Way (Curb Ramps)

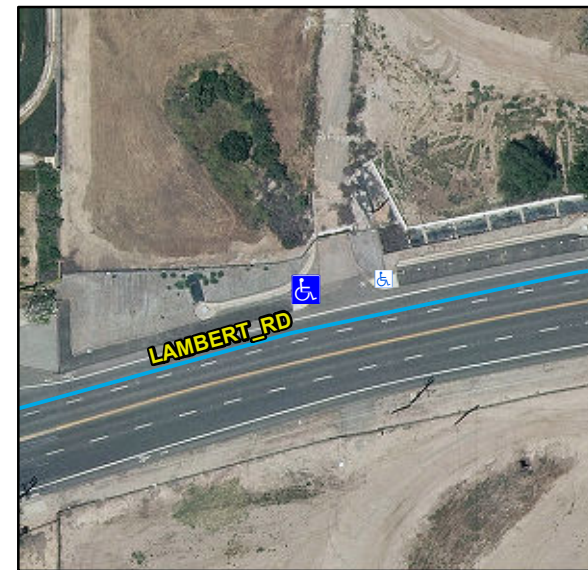

Main Street: N/A		Cross Street: LAMBERT_RD		Location: N	
ADA ID: RPRK220201123241	Ramp Type: Type 6 - Directional 1	Initial Pass/Fail: Pass	Overall Compliance: No	Severity Score: 10	
Codes/Mitigation Info/Possible Solution			Field Measurements/Component Compliance		



Possible Solutions:

Install Landing. Remove & Replace Gutter.

Surveyor Notes:

N/A

OC Std/PROW:

R304.2.1, R304.2.2-Perp, R304.3.2-Para, R304.5.3, R302.7, STD 1115

Total Cost: \$ 783

Parcel ID Number 320-073-09
Ramp Island Or Median None
Ramp Orientation NonDiag
Google Street View Link:

Street 1 Name N/A
Stop Condition-Street 1 NoControl
Street 2 Name LAMBERT_RD
Stop Condition-Street 2 N/A

http://www.google.com/maps/@?api=1&map_action=pano&viewpoint=33.92391732,-117.85488885

Obstruction and Utility Measurement/Component Compliance

Compliance	Description	Data	Compliance	Description	Data
Yes	Obstructions Present?	No	N/A	Utilities Present?	No
	Obstruction Types	N/A		Utility Types	
	Obstruction Dimensions	N/A			N/A



Compliance	Description	Data	Compliance	Description	Data
N/A	Ramp Length (in)	140	N/A	Flare Type LT	
Yes	Ramp Width (in)	65			Sloped
Yes	Ramp Run Slope (%)	6.6	Yes	Flare Slope LT (%)	5.9
Yes	Ramp Cross Slope (%)	0.5	N/A	Flare Traversable LT	Yes
Yes	Grade Break	Yes	Yes	Flare Type RT	
Yes	Grade Break Slope (%)	0.8			Curbed2
Yes	Grade Break Cross Slope (%)	0.8	N/A	Flare Slope RT (%)	N/A
	Addl Para Ramp Left?	No	N/A	Flare Traversable RT	N/A
	Addl Para Ramp Right?	No	Yes	DWS Provided	Yes
N/A	Landing Present	No	Yes	DWS Contrast	Yes
No	Landing Length (in)	N/A	Yes	DWS Length (in)	80
No	Landing Width (in)	N/A	Yes	DWS Full Width	Yes
No	Landing Run Slope (%)	N/A		DWS Offset Type	Single
No	Landing Cross Slope (%)	N/A	Yes	DWS Left Offset (in)	0
N/A	Landing Movement Obstructed?	No	N/A	DWS Right Offset (in)	0
	Landing Movement Type	N/A			
N/A	Landing Shared	N/A			
N/A	Marked Crosswalk 1	No	N/A	Clear Space	N/A
	Crossing 1 Direction	E	N/A	Clear Space To Crosswalk (in)	N/A
N/A	Marked Crosswalk 1 Width (in)	N/A			
N/A	Ramp Inside Crosswalk 1	N/A			
	Crossing 1 Slope (%)	3.7			
	Crossing 1 Cross Slope (%)	0.8			
No	Gutter Ponding	Yes	Yes	Curb Slope	3.7
Yes	Gutter Lip Height (in)	0		Road Run Slope (%)	N/A
Yes	Gutter Run Slope (%)	3.7		Road Cross Slope (%)	N/A
No	Gutter Cross Slope (%)	2.2		Parallel Ramp Side	Right
Yes	Overall Surface Condition	Acceptable	Yes	Perp Joint Present	Yes
	Cross Gutter Present?	No		Spandrel Present?	No
	Replace Cross Gutter?	N/A		Replace Spandrel?	N/A