




Access Compliance Report

Public Rights-of-Way (Curb Ramps)



Main Street: MADISON_AVE		Cross Street: NEWLAND_ST		Location:	NW
ADA ID: RPRK220203130749	Ramp Type: Type 4 - Parallel	Initial Pass/Fail: Fail	Overall Compliance: No	Severity Score:	15

Codes/Mitigation Info/Possible Solution			Field Measurements/Component Compliance		
---	--	--	---	--	--

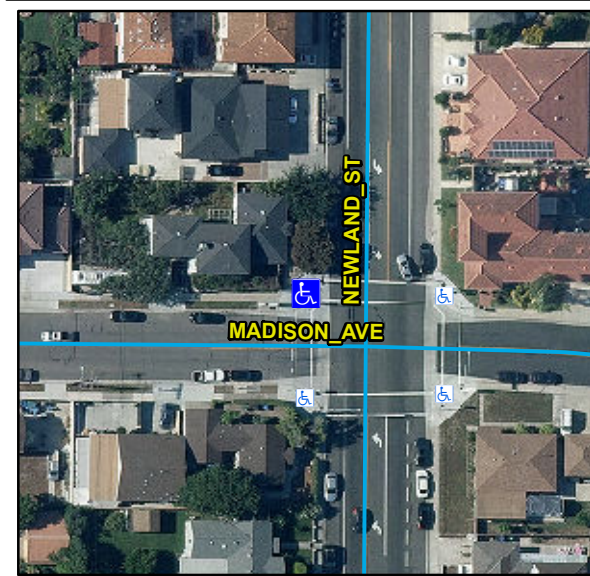

Possible Solutions:

Remove & Replace Curb Ramp With Two New Directional Ramps or Equivalent.

Surveyor Notes:

N/A

OC Std/PROW:

R304.5.3, STD 1115


Total Cost: \$ 4000

Parcel ID Number	097-164-22	Street 1 Name	MADISON_AVE
Ramp Island Or Median	None	Stop Condition-Street 1	Signal
Ramp Orientation	Diag	Street 2 Name	NEWLAND_ST
Google Street View Link:		Stop Condition-Street 2	Signal

http://www.google.com/maps/@?api=1&map_action=pano&viewpoint=33.74849772,-117.98107826

Obstruction and Utility Measurement/Component Compliance

Compliance	Description	Data	Compliance	Description	Data
Yes	Obstructions Present?	No	N/A	Utilities Present?	Yes
	Obstruction Types	N/A		Utility Types	
	Obstruction Dimensions	N/A		Pull Box; Push Button; Traffic Signal Pole	

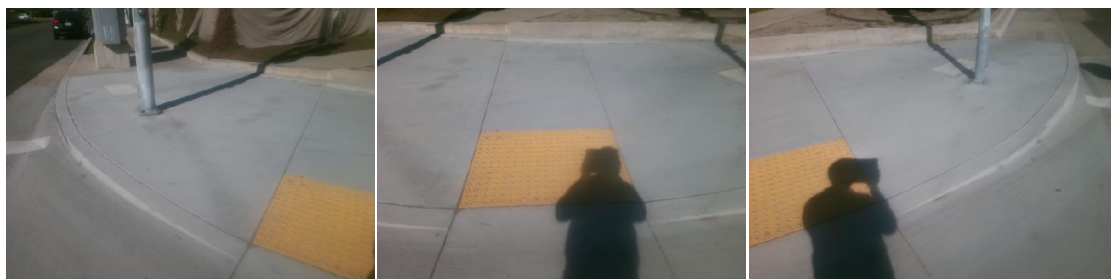

Compliance	Description	Data	Compliance	Description	Data
N/A	Ramp Length LT (in)	96	N/A	Ramp Length RT (in)	99
Yes	Ramp Width LT (in)	152	Yes	Ramp Width RT (in)	152
Yes	Ramp Run Slope LT (%)	7.8	Yes	Ramp Run Slope RT (%)	4.8
No	Ramp Cross Slope LT (%)	4.3	No	Ramp Cross Slope RT (%)	5.1
N/A	Landing Present	N/A	N/A	DWS Provided	N/A
N/A	Landing Length (in)	N/A	N/A	DWS Contrast	N/A
N/A	Landing Width (in)	N/A	N/A	DWS Length (in)	N/A
N/A	Landing Run Slope (%)	N/A	N/A	DWS Full Width	N/A
N/A	Landing Cross Slope (%)	N/A		DWS Offset Type	N/A
N/A	Landing Movement Obstructed?	N/A	N/A	DWS Offset Left (in)	N/A
	Landing Movement Type	N/A	N/A	DWS Offset Right (in)	N/A
N/A	Landing Shared	N/A			
N/A	Clear Space	Yes			
N/A	Clear Space To Crosswalk (in)	48			
N/A	Marked Crosswalk 1	Yes	N/A	Marked Crosswalk 2	Yes
	Crossing 1 Direction	S		Crossing 2 Direction	E
	Marked Crosswalk 1 Width (in)	144		Marked Crosswalk 2 Width (in)	144
N/A	Ramp Inside Crosswalk 1	Yes	N/A	Ramp Inside Crosswalk 2	Yes
	Crossing 1 Slope (%)	4.1		Crossing 2 Slope (%)	5
	Crossing 1 Cross Slope (%)	3.3		Crossing 2 Cross Slope (%)	0.4
N/A	Gutter Ponding	N/A	N/A	Curb Slope	3.1
Yes	Gutter Lip Height (in)	0		Road Run Slope (%)	1
N/A	Gutter Run Slope (%)	N/A		Road Cross Slope (%)	3.3
N/A	Gutter Cross Slope (%)	N/A	Yes	Perpendicular Joint Present	Yes
Yes	Overall Surface Condition	Acceptable			
	Cross Gutter Present?	Yes		Spandrel Present?	Yes
	Replace Cross Gutter?	No		Replace Spandrel?	No