




Access Compliance Report Public Rights-of-Way (Curb Ramps)

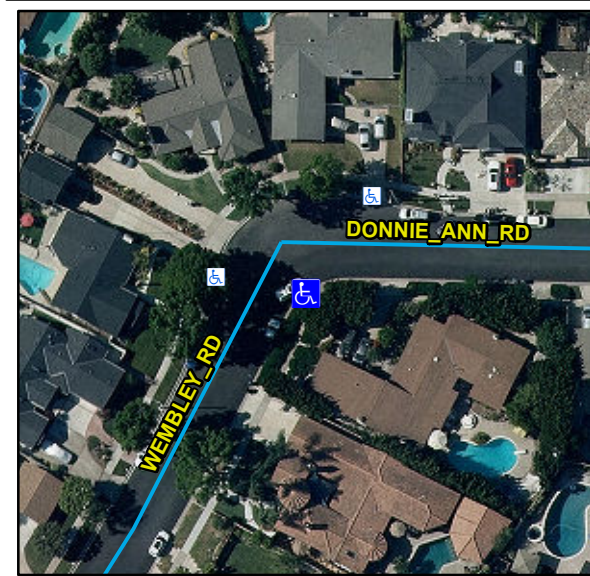

Main Street: WEMBLEY_RD		Cross Street: DONNIE_ANN_RD		Location:	S
ADA ID: RPRK220217171203	Ramp Type: No Ramp	Initial Pass/Fail: N/A	Overall Compliance: No	Severity Score:	100
Codes/Mitigation Info/Possible Solution			Field Measurements/Component Compliance		



Possible Solutions:

Provide Curb Ramp

Surveyor Notes:

N/A

OC Std/PROW:

STD 1115

Total Cost: \$ 3080

Parcel ID Number	086-554-01	Street 1 Name	WEMBLEY_RD
Ramp Island Or Median	N/A	Stop Condition-Street 1	N/A
Ramp Orientation	N/A	Street 2 Name	DONNIE_ANN_RD
Google Street View Link:		Stop Condition-Street 2	N/A

http://www.google.com/maps/@?api=1&map_action=pano&viewpoint=33.80088155,-118.07950189

Compliance	Description	Data	Compliance	Description	Data

