



Access Compliance Report Public Rights-of-Way (Curb Ramps)




Main Street: GREENWICH_LN Cross Street: BROADWAY Location: SW

ADA ID: RPRK220218210714 Ramp Type: Type 3 - Combination 1 Initial Pass/Fail: Fail Overall Compliance: No Severity Score: 5

Codes/Mitigation Info/Possible Solution

Field Measurements/Component Compliance

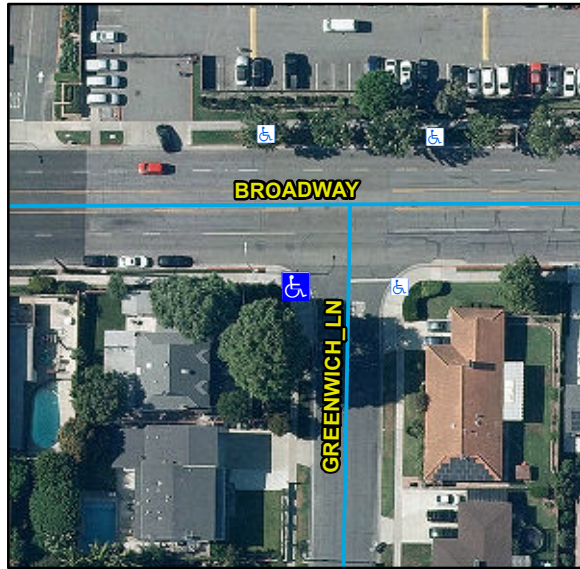

Possible Solutions:

Remove & Replace Curb Ramp With Two New Directional Ramps or Equivalent. Remove & Replace Sidewalk.

Surveyor Notes:

N/A

OC Std/PROW:

R304.5.1, R304.5.3, STD 1115

Total Cost: \$ 6538


Parcel ID Number 127-091-38
Ramp Island Or Median None
Ramp Orientation Diag
Google Street View Link:

Street 1 Name GREENWICH_LN
Stop Condition-Street 1 StopSign
Street 2 Name BROADWAY
Stop Condition-Street 2 NoControl

http://www.google.com/maps/@?api=1&map_action=pano&viewpoint=33.82871351,-117.96290856

Obstruction and Utility Measurement/Component Compliance

Compliance	Description	Data	Compliance	Description	Data
Yes	Obstructions Present?	No	N/A	Utilities Present?	No
	Obstruction Types	N/A		Utility Types	
	Obstruction Dimensions	N/A			N/A

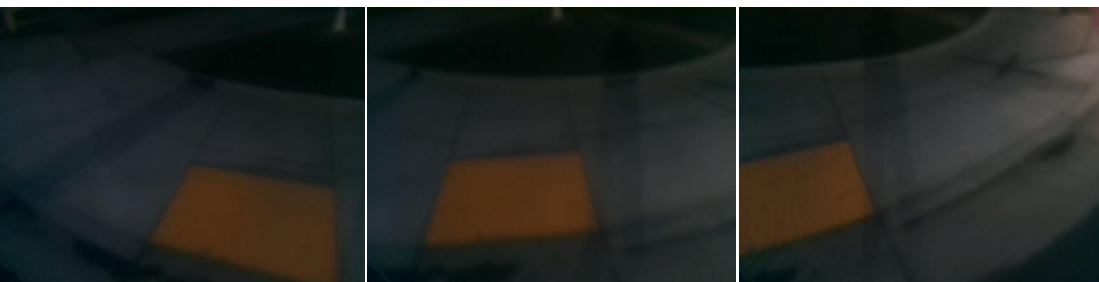

Compliance	Description	Data	Compliance	Description	Data
N/A	Ramp Length LT (in)	80	N/A	Ramp Length RT (in)	82
Yes	Ramp Width LT (in)	59	No	Ramp Width RT (in)	45
Yes	Ramp Run Slope LT (%)	8	Yes	Ramp Run Slope RT (%)	4
No	Ramp Cross Slope LT (%)	3.7	No	Ramp Cross Slope RT (%)	4.4
N/A	Ramp Length (in)	100	N/A	Flare Type LT	
Yes	Ramp Width (in)	48			N/A
Yes	Ramp Run Slope (%)	7.3	N/A	Flare Slope LT (%)	N/A
Yes	Ramp Cross Slope (%)	1.8	N/A	Flare Traversable LT	N/A
N/A	Landing Present	Yes	N/A	Flare Type RT	
N/A	Landing Length (in)	64			N/A
N/A	Landing Width (in)	48	N/A	Flare Slope RT (%)	N/A
N/A	Landing Run Slope (%)	0.5	N/A	Flare Traversable RT	N/A
N/A	Landing Cross Slope (%)	0.7	N/A	DWS Provided	Yes
N/A	Landing Movement Obstructed?	No	N/A	DWS Contrast	Yes
	Landing Movement Type	N/A	N/A	DWS Length (in)	36
N/A	Landing Shared	No	N/A	DWS Full Width	Yes
N/A	Clear Space	Yes		DWS Offset Type	Single
N/A	Clear Space To Crosswalk (in)	8	N/A	DWS Offset Left (in)	0
			N/A	DWS Offset Right (in)	N/A
Yes	Perp Joint Present	Yes			
	Parallel Ramp Side	N/A			
N/A	Marked Crosswalk 1	No	N/A	Marked Crosswalk 2	No
	Crossing 1 Direction	E		Crossing 2 Direction	N
	Marked Crosswalk 1 Width (in)	N/A		Marked Crosswalk 2 Width (in)	N/A
N/A	Ramp Inside Crosswalk 1	N/A	Yes	Ramp Inside Crosswalk 2	N/A
	Crossing 1 Slope (%)	4.9		Crossing 2 Slope (%)	3.9
	Crossing 1 Cross Slope (%)	0.8		Crossing 2 Cross Slope (%)	0.9
N/A	Gutter Ponding	No	N/A	Curb Slope	2.6
Yes	Gutter Lip Height (in)	0		Road Run Slope (%)	4.2
N/A	Gutter Run Slope (%)	7.8		Road Cross Slope (%)	1.7
N/A	Gutter Cross Slope (%)	1.8			
Yes	Overall Surface Condition: Acceptable				
	Cross Gutter Present?	No		Spandrel Present?	No
	Replace Cross Gutter?	N/A		Replace Spandrel?	N/A