




# Access Compliance Report Public Rights-of-Way (Pedestrian Signals)



Main Street: **HOLT\_AVE** Cross Street: **17TH\_ST** Location: **NE**

ADA ID: **SGRK211007144700** Signal Type: **One Push Button-APS** Overall Compliance: **No** Severity Scores: **BTN 1: 25** **BTN 2: N/A** **No BTN: N/A**

Codes/Mitigation Info/Possible Solution Field Measurements/Component Compliance

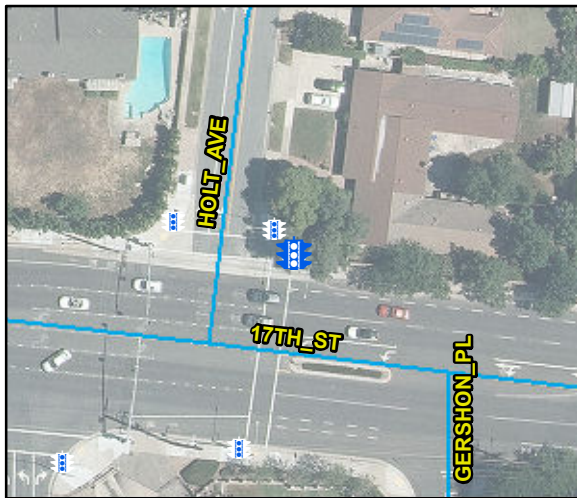


Possible Solutions: Remove and Replace Clear Space.

Surveyor Notes: **N/A**

OC Std/PROW: **R404.2**

Total Cost: \$ **378**

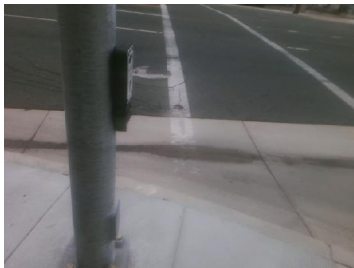

## APS Compliance

|                                     |               |                                     |     |
|-------------------------------------|---------------|-------------------------------------|-----|
| N/A Is Button 1 APS or Non-APS?     | APS           | N/A Is Button 2 APS or Non-APS?     | N/A |
| N/A B 1 VibroTact Arrow?            | Yes           | N/A B 2 VibroTact Arrow?            | N/A |
| Yes B 1 VibroTact Parallel to Xing? | Yes           | N/A B 2 VibroTact Parallel to Xing? | N/A |
| N/A B 1 VibroTact Contrast          | Yes           | N/A B 2 VibroTact Contrast          | N/A |
| Yes B 1 Pilot Light?                | Yes           | N/A B 2 Pilot Light?                | N/A |
| Yes B 1 Pilot Light Illumination?   | Yes           | N/A B 2 Pilot Light Illumination?   | N/A |
| N/A B 1 Walk Indicator Type         | VerbalMessage | N/A B 2 Walk Indicator Type         | N/A |
| N/A B 1 Walk Indicator Audible?     | Yes           | N/A B 2 Walk Indicator Audible?     | N/A |
| N/A B 1 Locator Tone?               | Yes           | N/A B 2 Locator Tone?               | N/A |
| N/A B 1 Tone Audible Range?         | Yes           | N/A B 2 Tone Audible Range?         | N/A |
| B 1 Addl APS Features?              | No            | B 2 Addl APS Features?              | N/A |
| B 1 Addl APS Features Notes         | N/A           | B 2 Addl APS Features Notes         | N/A |

| Compliance | Description                             | Data   | Compliance | Description                             | Data             |
|------------|-----------------------------------------|---|------------|-----------------------------------------|------------------|
|            | Button Count                            | Button1   | Yes        | Distant to Additional Button (in)       | 190              |
|            | Additional Button Present?              | Yes   | N/A        | Additional Button ID                    | SGRK211007144549 |
|            | Located In An Island/Median?            | No   |            |                                         |                  |
| N/A        | B 1 Sign Present?                       | Yes   | N/A        | B 2 Sign Present?                       | N/A              |
| Yes        | B 1 Sign Purpose?                       | Yes   | N/A        | B 2 Sign Purpose?                       | N/A              |
| Yes        | B 1 Sign Lettering & Contrast?          | Yes   | N/A        | B 2 Sign Lettering & Contrast?          | N/A              |
| Yes        | B 1 Parallel To XWalk?                  | Yes   | N/A        | B 2 Parallel To XWalk?                  | N/A              |
| N/A        | B 1 PAR to Button?                      | N/A   | N/A        | B 2 PAR to Button?                      | N/A              |
| N/A        | B 1 PAR to XWalk?                       | N/A   | N/A        | B 2 PAR to XWalk?                       | N/A              |
| Yes        | B 1 Clear Floor Space?                  | Yes   | N/A        | B 2 Clear Floor Space?                  | N/A              |
| N/A        | B 1 FWD Approach?                       | N/A   | N/A        | B 2 FWD Approach?                       | N/A              |
| N/A        | B 1 FWD Approach Constrained?           | N/A   | N/A        | B 2 FWD Approach Constrained?           | N/A              |
| N/A        | B 1 FWD Approach Reach (in)             | N/A   | N/A        | B 2 FWD Approach Reach (in)             | N/A              |
| N/A        | B 1 FWD Approach Width (in)             | N/A   | N/A        | B 2 FWD Approach Width (in)             | N/A              |
| N/A        | B 1 FWD Approach Obstruction?           | N/A   | N/A        | B 2 FWD Approach Obstruction?           | N/A              |
| N/A        | B 1 FWD Approach Obstruction Dist (in)  | N/A   | N/A        | B 2 FWD Approach ObstructionDist (in)   | N/A              |
| N/A        | B 1 PARA Approach?                      | N/A   | N/A        | B 2 PARA Approach?                      | N/A              |
| N/A        | B 1 PARA Approach Constrained?          | No   | N/A        | B 2 PARA Approach Constrained?          | N/A              |
| Yes        | B 1 PARA Approach Reach (in)            | 0   | N/A        | B 2 PARA Approach Reach (in)            | N/A              |
| N/A        | B 1 PARA Approach Width (in)            | N/A   | N/A        | B 2 PARA Approach Width (in)            | N/A              |
| N/A        | B 1 PARA Approach Obstruction?          | No   | N/A        | B 2 PARA Approach Obstruction?          | N/A              |
| N/A        | B 1 PARA Approach Obstruction Dist (in) | N/A   | N/A        | B 2 PARA Approach Obstruction Dist (in) | N/A              |
| Yes        | B 1 Clear Floor Space Slope (%)         | 2.4   | N/A        | B 2 Clear Floor Space Slope (%)         | N/A              |
| No         | B 1 Clear Floor Space XSlope (%)        | 2.6   | N/A        | B 2 Clear Floor Space XSlope (%)        | N/A              |
| N/A        | B 1 PAR Slope (%)                       | 8.7   | N/A        | B 2 PAR Slope (%)                       | N/A              |
| Yes        | B 1 Height (in)                         | 39   | N/A        | B 2 Height (in)                         | N/A              |
| Yes        | B 1 Pressure (#)                        | 5   | N/A        | B 2 Pressure (#)                        | N/A              |
| Yes        | B 1 Closed Fist Operation?              | Yes   | N/A        | B 2 Closed Fist Operation?              | N/A              |
| Yes        | B 1 Diameter (in)                       | 2   | N/A        | B 2 Diameter (in)                       | N/A              |
| N/A        | B 1 Crossing Direction                  | S   | N/A        | B 2 Crossing Direction                  | N/A              |
| Yes        | B 1 DistanceTo XWalk (in)               | 34   | N/A        | B 2 DistanceTo XWalk (in)               | N/A              |
| Yes        | B 1 DistanceTo Curb (in)                | 32   | N/A        | B 2 DistanceTo Curb (in)                | N/A              |
|            | Parcel Identification Number            | 395-124-05   |            |                                         |                  |
|            | Google Street View Link                 |   |            |                                         |                  |
|            |                                         | <a href="http://www.google.com/maps/@?api=1&amp;map_action=pano&amp;viewpoint=33.76010494,-117.81385711">http://www.google.com/maps/@?api=1&amp;map_action=pano&amp;viewpoint=33.76010494,-117.81385711</a> |            |                                         |                  |