



Access Compliance Report Public Rights-of-Way (Pedestrian Signals)




Main Street: **HOLT_AVE** Cross Street: **17TH_ST** Location: **SW**

ADA ID: **SGRK211007150426** Signal Type: **One Push Button-APS** Overall Compliance: **No** Severity Scores: **BTN 1: 25** **BTN 2: N/A** **No BTN: N/A**

Codes/Mitigation Info/Possible Solution

Field Measurements/Component Compliance

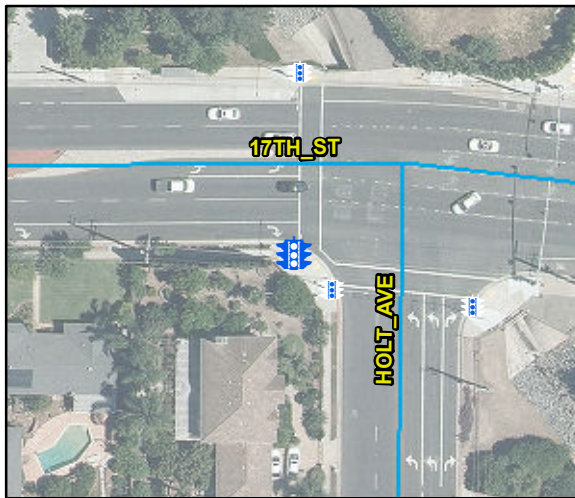

Possible Solutions: Remove and Replace Clear Space.

Surveyor Notes: **N/A**

OC Std/PROW: **R404.2**

Total Cost: \$ **378**



APS Compliance

N/A Is Button 1 APS or Non-APS?	APS	N/A Is Button 2 APS or Non-APS?	N/A
N/A B 1 VibroTact Arrow?	Yes	N/A B 2 VibroTact Arrow?	N/A
Yes B 1 VibroTact Parallel to Xing?	Yes	N/A B 2 VibroTact Parallel to Xing?	N/A
N/A B 1 VibroTact Contrast	Yes	N/A B 2 VibroTact Contrast	N/A
Yes B 1 Pilot Light?	Yes	N/A B 2 Pilot Light?	N/A
Yes B 1 Pilot Light Illumination?	Yes	N/A B 2 Pilot Light Illumination?	N/A
N/A B 1 Walk Indicator Type	VerbalMessage	N/A B 2 Walk Indicator Type	N/A
N/A B 1 Walk Indicator Audible?	Yes	N/A B 2 Walk Indicator Audible?	N/A
N/A B 1 Locator Tone?	Yes	N/A B 2 Locator Tone?	N/A
N/A B 1 Tone Audible Range?	Yes	N/A B 2 Tone Audible Range?	N/A
B 1 Addl APS Features?	No	B 2 Addl APS Features?	N/A
B 1 Addl APS Features Notes	N/A	B 2 Addl APS Features Notes	N/A

Compliance	Description	Data	Compliance	Description	Data
	Button Count	Button1	Yes	Distant to Additional Button (in)	353
	Additional Button Present?	Yes	N/A	Additional Button ID	SGRK211007150224
	Located In An Island/Median?	No			
N/A	B 1 Sign Present?	Yes	N/A	B 2 Sign Present?	N/A
Yes	B 1 Sign Purpose?	Yes	N/A	B 2 Sign Purpose?	N/A
Yes	B 1 Sign Lettering & Contrast?	Yes	N/A	B 2 Sign Lettering & Contrast?	N/A
Yes	B 1 Parallel To XWalk?	Yes	N/A	B 2 Parallel To XWalk?	N/A
N/A	B 1 PAR to Button?	N/A	N/A	B 2 PAR to Button?	N/A
N/A	B 1 PAR to XWalk?	N/A	N/A	B 2 PAR to XWalk?	N/A
Yes	B 1 Clear Floor Space?	Yes	N/A	B 2 Clear Floor Space?	N/A
N/A	B 1 FWD Approach?	N/A	N/A	B 2 FWD Approach?	N/A
N/A	B 1 FWD Approach Constrained?	N/A	N/A	B 2 FWD Approach Constrained?	N/A
N/A	B 1 FWD Approach Reach (in)	N/A	N/A	B 2 FWD Approach Reach (in)	N/A
N/A	B 1 FWD Approach Width (in)	N/A	N/A	B 2 FWD Approach Width (in)	N/A
N/A	B 1 FWD Approach Obstruction?	N/A	N/A	B 2 FWD Approach Obstruction?	N/A
N/A	B 1 FWD Approach Obstruction Dist (in)	N/A	N/A	B 2 FWD Approach ObstructionDist (in)	N/A
N/A	B 1 PARA Approach?	N/A	N/A	B 2 PARA Approach?	N/A
N/A	B 1 PARA Approach Constrained?	No	N/A	B 2 PARA Approach Constrained?	N/A
Yes	B 1 PARA Approach Reach (in)	0	N/A	B 2 PARA Approach Reach (in)	N/A
N/A	B 1 PARA Approach Width (in)	N/A	N/A	B 2 PARA Approach Width (in)	N/A
N/A	B 1 PARA Approach Obstruction?	No	N/A	B 2 PARA Approach Obstruction?	N/A
N/A	B 1 PARA Approach Obstruction Dist (in)	N/A	N/A	B 2 PARA Approach Obstruction Dist (in)	N/A
Yes	B 1 Clear Floor Space Slope (%)	1.5	N/A	B 2 Clear Floor Space Slope (%)	N/A
No	B 1 Clear Floor Space XSlope (%)	6.1	N/A	B 2 Clear Floor Space XSlope (%)	N/A
N/A	B 1 PAR Slope (%)	5.2	N/A	B 2 PAR Slope (%)	N/A
Yes	B 1 Height (in)	39	N/A	B 2 Height (in)	N/A
Yes	B 1 Pressure (#)	5	N/A	B 2 Pressure (#)	N/A
Yes	B 1 Closed Fist Operation?	Yes	N/A	B 2 Closed Fist Operation?	N/A
Yes	B 1 Diameter (in)	2	N/A	B 2 Diameter (in)	N/A
N/A	B 1 Crossing Direction	N	N/A	B 2 Crossing Direction	N/A
Yes	B 1 DistanceTo XWalk (in)	22	N/A	B 2 DistanceTo XWalk (in)	N/A
Yes	B 1 DistanceTo Curb (in)	29	N/A	B 2 DistanceTo Curb (in)	N/A
	Parcel Identification Number	401-441-01			
	Google Street View Link				
		http://www.google.com/maps/@?api=1&map_action=pano&viewpoint=33.75987309,-117.81455645			