

Designation: 1A-128-74

Date Destroyed:

Date Revised:

GPS #:

OCS Index Map: Q05-14


Page/Grid: 796/J-6

City / Location: Seal Beach

Line #/SSN: 401/0060

Established By: OCS 1974

Monument Type: Orange County Surveyor's 3 3/4"
Aluminum Disk

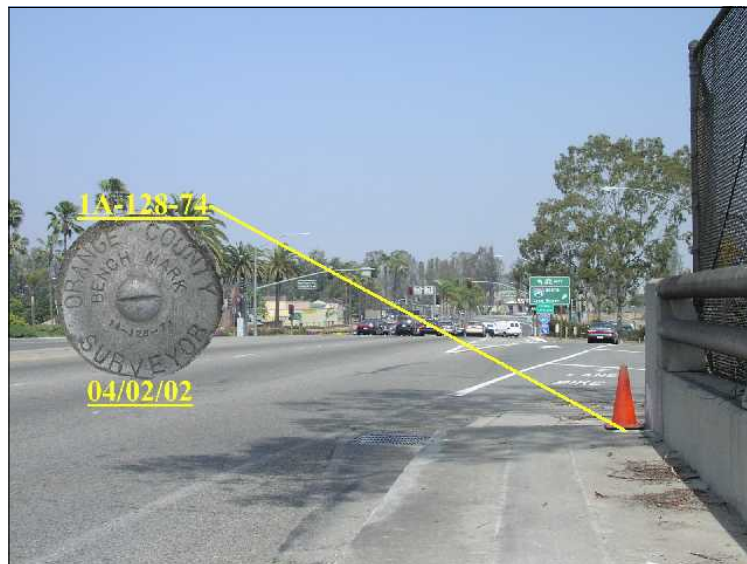

NAVD88 (ft)	NGVD29 (ft)	Year Leveled
40.663	38.244	2005
40.755	38.287	1989

For Reconnaissance Only!	
Latitude (30' +/-)	Longitude (30' +/-)
33 46 29.67	118 04 27.68

Description:

DESCRIBED BY OCS 2002 - FOUND 3 3/4" OCS ALUMINUM BENCHMARK DISK STAMPED "1A-128-74", SET IN THE TOP OF A CONCRETE BRIDGE DECK. MONUMENT IS LOCATED IN THE NORTHEASTERLY CORNER OF THE 405 FREEWAY AND SEAL BEACH BOULEVARD CROSSING, 1.1 MILES NORTHERLY OF THE CENTERLINE OF WESTMINSTER BOULEVARD AND IN THE EASTERLY END OF THE NORTHERLY BRIDGE ABUTMENT. MONUMENT IS SET LEVEL WITH THE SIDEWALK.

