

## Designation: 1B-74-69

Date Destroyed:

Date Revised:

GPS #:

OCS Index Map: Q05-12


Page/Grid: 797/H-2

City / Location: Stanton

Line #/SSN: 152/0150

Established By: OCS 1969

Monument Type: Orange County Surveyor's 3 3/4"  
Aluminum Disk

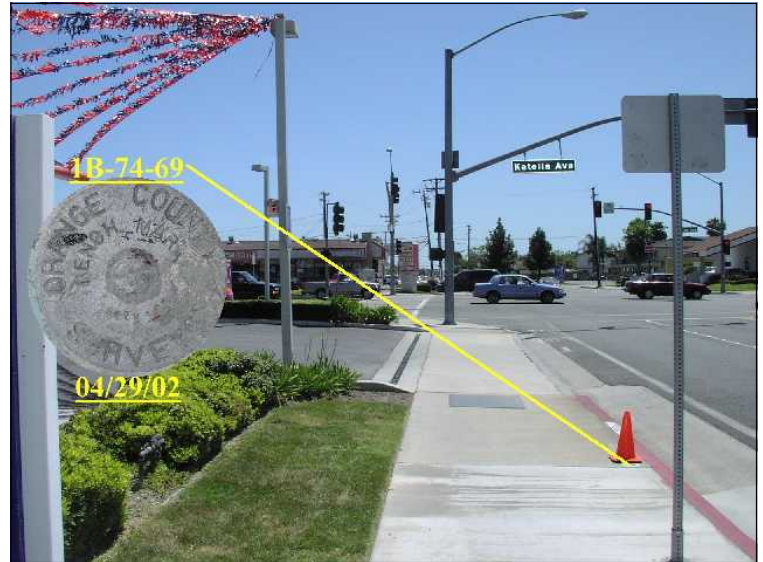

NAVD88 (ft)	NGVD29 (ft)	Year Leveled
59.200	56.781	2005
59.262	56.795	1990

For Reconnaissance Only!	
Latitude (30' +/-)	Longitude (30' +/-)
33 48 11.56	118 00 06.52

### Description:

DESCRIBED BY OCS 2002 - FOUND 3 3/4" OCS ALUMINUM BENCHMARK DISK STAMPED "1B-74-69", SET IN THE NORTHWESTERLY CORNER OF A 15 FT. BY 8 FT. CONCRETE CATCH BASIN. MONUMENT IS LOCATED IN THE NORTHEASTERLY CORNER OF THE INTERSECTION OF WESTERN AVENUE AND KATELLA AVENUE, 34.5 FT. EASTERLY OF THE CENTERLINE OF WESTERN AVENUE AND 145 FT. NORTHERLY OF THE CENTERLINE OF KATELLA. MONUMENT IS SET LEVEL WITH THE SIDEWALK.

