

Designation: 1G-149-74

Date Destroyed:

Date Revised:

GPS #: 1620

OCS Index Map: Q06-13


Page/Grid: 828/C-1

City / Location: Garden Grove

Line #/SSN: 157/0140

Established By: OCS 1974

Monument Type: Orange County Surveyor's 3 3/4"
Aluminum Disk

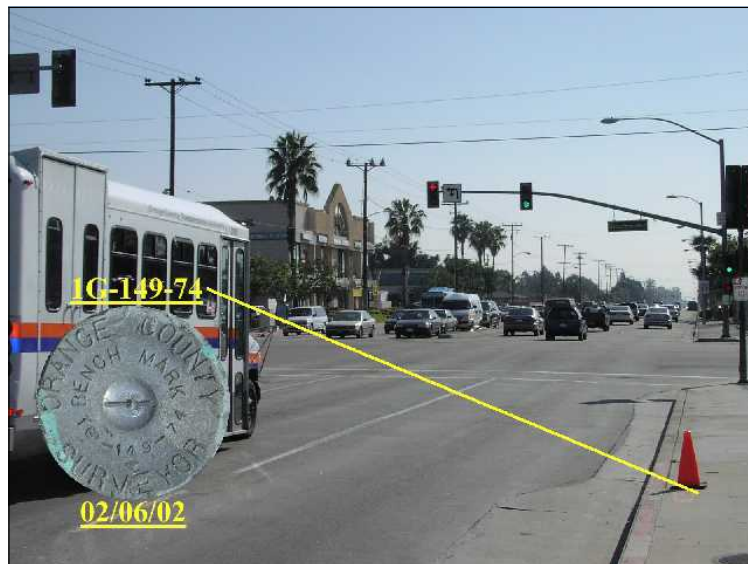

NAVD88 (ft)	NGVD29 (ft)	Year Leveled
55.225	52.809	2005
55.338	52.893	1992

For Reconnaissance Only!	
Latitude (30' +/-)	Longitude (30' +/-)
33 45 35.11	117 58 21.19

Description:

DESCRIBED BY OCS 2002 - FOUND 3 3/4" OCS ALUMINUM BENCHMARK DISK STAMPED "1G-149-74", SET IN THE SOUTHEAST CORNER OF A 4.5 FT. BY 13 FT. CONCRETE CATCH BASIN. MONUMENT IS LOCATED IN THE NORTHWEST CORNER OF THE INTERSECTION OF MAGNOLIA STREET AND WESTMINSTER AVENUE, 43 FT. WESTERLY OF THE CENTERLINE OF MAGNOLIA STREET AND 126 FT. NORTHERLY OF THE CENTERLINE OF WESTMINSTER AVENUE. MONUMENT IS SET LEVEL WITH THE SIDEWALK.

