

VERTICAL CONTROL DATA SHEET O.C.S. 1995 ADJUSTMENT



Designation: 1H-143-90

Date Destroyed:

Date Revised:

GPS #:


OCS Index Map: Q05-12 Page/Grid: 797/G-3 City / Location: Stanton

Line #/SSN: 158/0250 Established By: OCS 1990

Monument Type: Orange County Surveyor's 3 3/4"

Aluminum Disk

NAVD88 (ft)	NGVD29 (ft)	Year Leveled
52.078	49.659	2005
52.155	49.687	1990

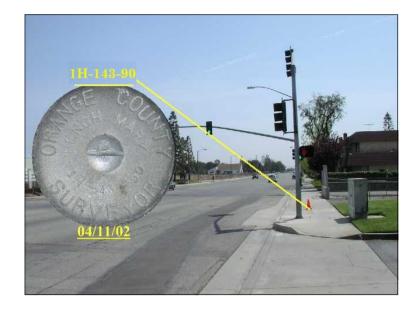

For Reconnaisance Only!		
Latitude (30' +/-)	Longitude (30' +/-)	
33 47 57.84	118 00 40.27	

Description:

DESCRIBED BY OCS 2002 - FOUND 3 3\4" OCS ALUMINUM BENCHMARK DISK STAMPED "1H-43-90", SET IN THE SOUTHWESTERLY CORNER OF A 4.5 FT. BY 7.5 FT. CONCRETE CATCH BASIN. MONUMENT IS LOCATED ALONG THE WESTERLY SIDE OF KNOTT AVENUE, 0.25 MILES SOUTHERLY OF KATELLA AVENUE, 46 FT. WESTERLY OF THE CENTERLINE OF KNOTT AND AT THE "T" INTERSECTION OF KNOTT AVENUE AND THE ENTRANCE TO THE MATERIAL RECOVERY FACILITY "PUBLIC DUMP". MONUMENT IS SET LEVEL WITH THE SIDEWALK.

