

VERTICAL CONTROL DATA SHEET O.C.S. 1995 ADJUSTMENT



Designation: 1J-55-80

Date Destroyed:

Date Revised:

GPS #:

OCS Index Map: Q10-07 Page/Grid: 857/B-2


City / Location: Huntington Beach

Line #/SSN: 400/1010 Established By: OCS 1980

Monument Type: Orange County Surveyor's 3 3/4"

Aluminum Disk

NAVD88 (ft)	NGVD29 (ft)	Year Leveled
7.810	5.394	2005
7.913	5.482	1989

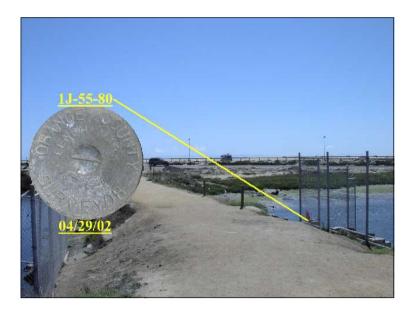

For Reconnaisance Only!		
Latitude (30' +/-)	Longitude (30' +/-)	
33 42 10.82	118 03 11.28	

Description:

DESCRIBED BY OCS 2002 - FOUND 3 3\4" OCS ALUMINUM BENCHMARK DISK STAMPED "1J-55-80", SET IN THE NORTHWESTERLY CORNER OF A CONCRETE HEADWALL. MONUMENT IS LOCATED ALONG THE NORTHEASTERLY SIDE OF PACIFIC COAST HIGHWAY WITHIN THE BOLSA CHICA ECOLOGICAL RESERVE, 0.85 MILES SOUTHWESTERLY ALONG PCH FROM THE CENTERLINE OF WARNER AVENUE AND 235 FT. NORTHEASTERLY OF THE CENTERLINE OF PCH. MONUMENT IS SET LEVEL WITH THE TOP OF THE WALL.

