

Designation: 1J-58-80

Date Destroyed:

Date Revised:

GPS #:

OCS Index Map: Q11-14


Page/Grid: 888/E-5

City / Location: Newport Beach

Line #/SSN: 400/0740

Established By: OCS 1980

Monument Type: Orange County Surveyor's 3 3/4"
Aluminum Disk

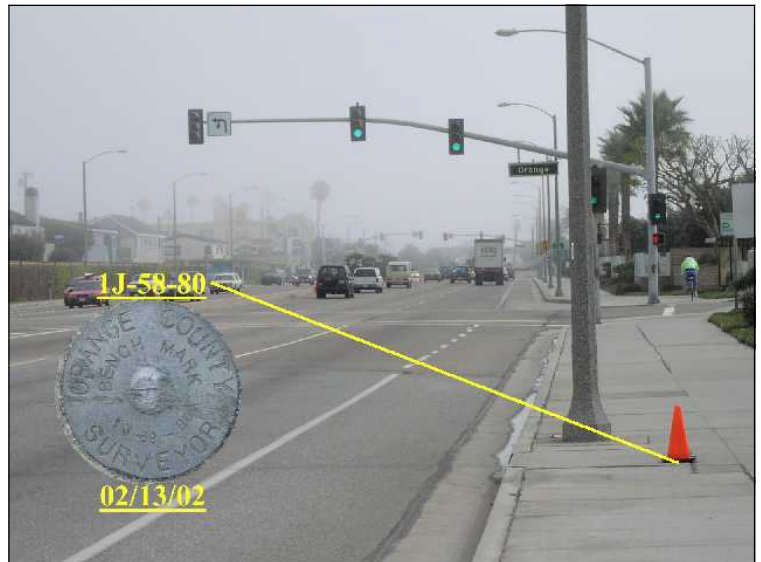

NAVD88 (ft)	NGVD29 (ft)	Year Leveled
9.274	6.869	2005
9.365	6.931	1992

For Reconnaissance Only!	
Latitude (30' +/-)	Longitude (30' +/-)
33 37 42.31	117 57 11.06

Description:

DESCRIBED BY OCS 2002 - FOUND 3 3/4" OCS ALUMINUM BENCHMARK DISK STAMPED "1J-58-80", SET IN THE NORTHWEST CORNER OF A 5 FT. BY 6 FT. CONCRETE CATCH BASIN. MONUMENT IS LOCATED IN THE NORTHWEST CORNER OF THE INTERSECTION OF PACIFIC COAST HIGHWAY AND ORANGE STREET, 192 FT. NORTHWESTERLY OF THE CENTERLINE OF ORANGE STREET AND 58 FT. SOUTHWESTERLY OF THE CENTERLINE OF PCH. MONUMENT IS SET LEVEL WITH THE SIDEWALK.

