

Designation: 1L-91-89

Date Destroyed:

Date Revised:

GPS #:

OCS Index Map: Q04-13


Page/Grid: 741/C-5

City / Location: Yorba Linda

Line #/SSN: 161/0490

Established By: OCS 1989

Monument Type: Orange County Surveyor's 3 3/4"
Aluminum Disk

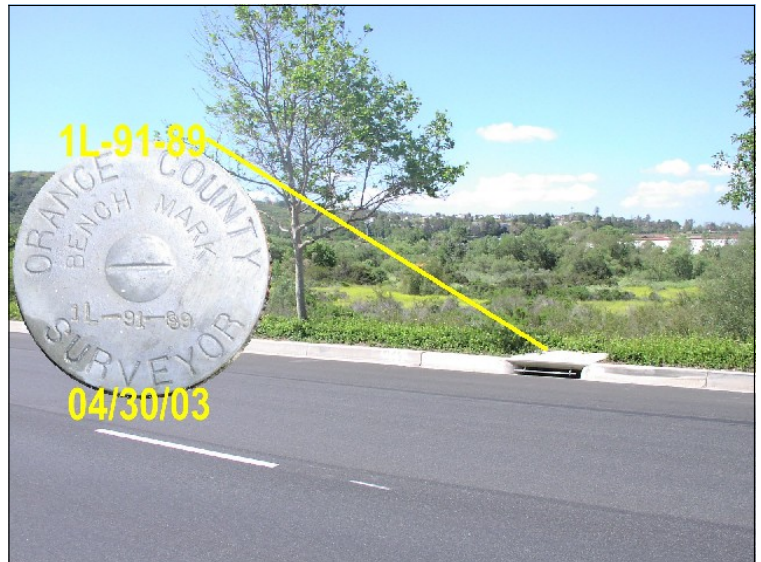

NAVD88 (ft)	NGVD29 (ft)	Year Leveled
363.947	361.528	1992

For Reconnaissance Only!	
Latitude (30' +/-)	Longitude (30' +/-)
33 52 35.87	117 43 52.35

Description:

DESCRIBED BY OCS 2003 - FOUND 3 3/4" OCS ALUMINUM BENCHMARK DISK STAMPED "1L-91-89", SET IN THE SOUTHEASTERLY CORNER OF A 4 FT. BY 4.5 FT. CONCRETE CATCH BASIN. MONUMENT IS LOCATED ALONG THE SOUTHERLY SIDE OF LA PALMA AVENUE, 0.35 MILES EASTERLY OF VIA LOMAS DE YORBA WEST, 43.6 FT. SOUTHERLY OF THE CENTERLINE OF LA PALMA AND 23 FT. EASTERLY OF STREET STANDARD (2281336E). MONUMENT IS SET LEVEL WITH THE TOP OF THE CURB.

