

## Designation: 2K-21-75

Date Destroyed:

Date Revised:

GPS #: 0129

OCS Index Map: Q02-09


Page/Grid: 708/B-6

City / Location: La Habra

Line #/SSN: 260/0100

Established By: OCS 1975

Monument Type: Orange County Surveyor's 3 3/4"  
Aluminum Disk

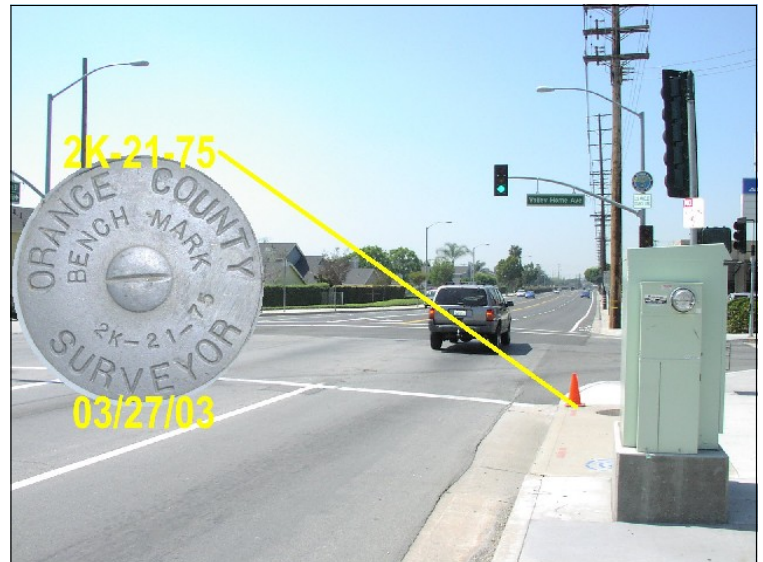

NAVD88 (ft)	NGVD29 (ft)	Year Leveled
297.784	295.368	2005
297.819	295.403	1990

For Reconnaissance Only!	
Latitude (30' +/-)	Longitude (30' +/-)
33 55 55.03696	117 58 35.00597

### Description:

DESCRIBED BY OCS 2003 - FOUND 3 3/4" OCS ALUMINUM BENCHMARK DISK STAMPED "2K-21-75", SET IN THE SOUTHWESTERLY CORNER OF A 4 FT. BY 11 FT. CONCRETE CATCH BASIN. MONUMENT IS LOCATED IN THE NORTHEASTERLY CORNER OF THE INTERSECTION OF LA HABRA BOULEVARD AND VALLEY HOME AVENUE, 45 FT. EASTERLY OF THE CENTERLINE OF VALLEY HOME AND 32 FT. NORTHERLY OF THE CENTERLINE OF LA HABRA. MONUMENT IS SET LEVEL WITH THE SIDEWALK.

