

## Designation: 3A-79-70

Date Destroyed:

Date Revised: 7/2/2007

GPS #:

OCS Index Map: Q07-15


Page/Grid: 800/E-7

City / Location: Cowan Heights

Line #/SSN: 351/0140

Established By: OCS 1970

Monument Type: Orange County Surveyor's 3 3/4"  
Aluminum Disk

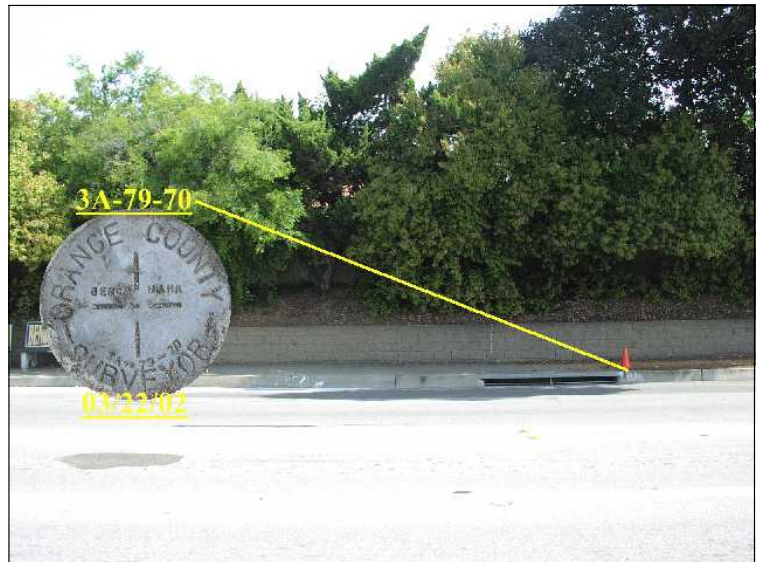

NAVD88 (ft)	NGVD29 (ft)	Year Leveled
274.890	272.460	2010
274.890	272.460	1991

For Reconnaissance Only!	
Latitude (30' +/-)	Longitude (30' +/-)
33 46 01.63677	117 47 43.32166

### Description:

DESCRIBED BY OCS 2002 - FOUND 3 3/4" OCS ALUMINUM BENCHMARK DISK STAMPED "3A-79-70", SET IN THE SOUTHEAST CORNER OF A 4 FT. BY 10 FT. CONCRETE CATCH BASIN. MONUMENT IS LOCATED IN THE NORTHWEST CORNER OF THE INTERSECTION OF FOOTHILL BOULEVARD AND NEWPORT AVENUE, 33.5 FT. NORTHEASTERLY OF THE CENTERLINE OF FOOTHILL BOULEVARD AND 73 FT. NORTHWESTERLY OF THE NORTHWEST CURB ALONG NEWPORT BOULEVARD. MONUMENT IS SET LEVEL WITH THE SIDEWALK.

