

Designation: 3B-117-13

Date Destroyed:

Date Revised: 4/9/2014

GPS #:

OCS Index Map: Q12-12


Page/Grid: 861/A-5

City / Location: Irvine

Line #/SSN: 402/0410

Established By: OCS 2013

Monument Type: Orange County Surveyor's 4"
Aluminum Disk

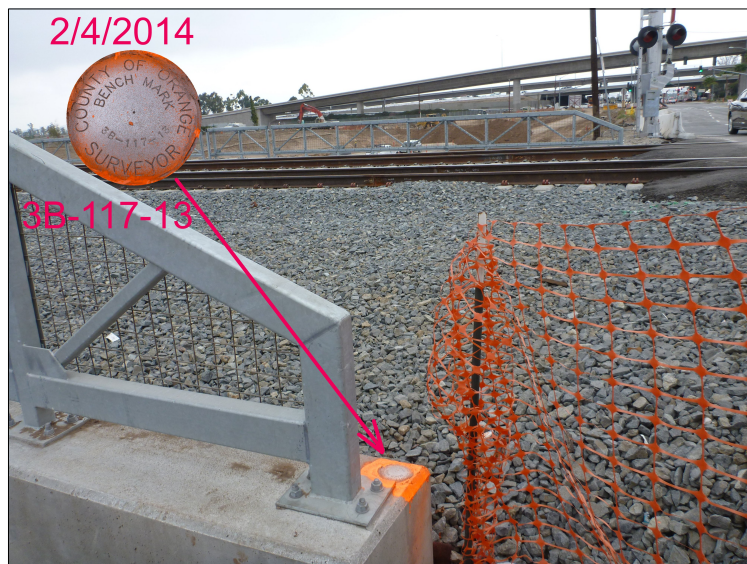

NAVD88 (ft)	NGVD29 (ft)	Year Leveled
200.328	197.941	2014

For Reconnaissance Only!	
Latitude (30' +/-)	Longitude (30' +/-)
33 40 33.19246	117 45 35.96344

Description:

DESCRIBED BY OCS 2013 – FOUND 4" OCS ALUMINUM BENCHMARK DISK STAMPED "3B-117-13", SET IN THE TOP OF THE SOUTHEASTERLY RAIL ROAD BRIDGE WALL CORNER NORTHEAST OF THE RAILROAD TRACKS. MONUMENT IS LOCATED +/- 420' SW'LY OF THE INTERSECTION OF SAND CANYON ROAD AND BURNT ROAD.

