

Designation: 3CC-10-83

Date Destroyed:

Date Revised:

GPS #:

OCS Index Map: Q17-06


Page/Grid: 921/J-3

City / Location: Laguna Hills

Line #/SSN: 376/0020

Established By: OCS 1983

Monument Type: Orange County Surveyor's 3 3/4"
Aluminum Disk

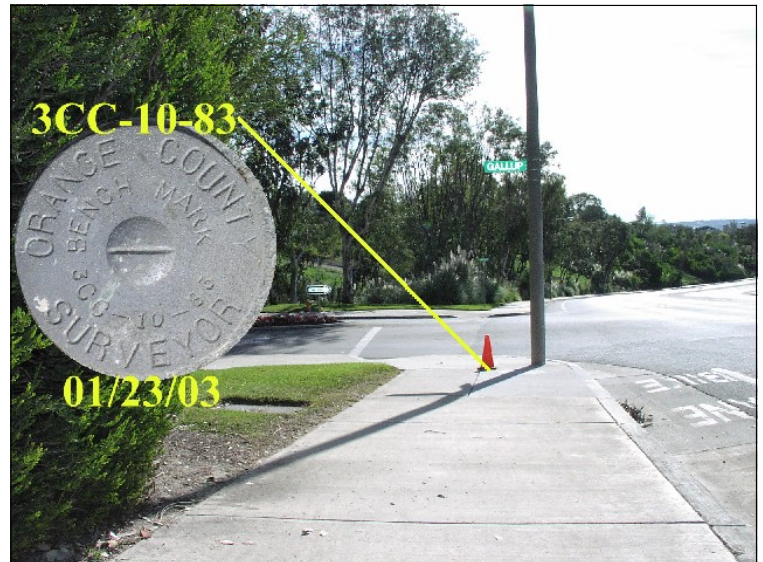

NAVD88 (ft)	NGVD29 (ft)	Year Leveled
472.608	470.262	1991

For Reconnaissance Only!	
Latitude (30' +/-)	Longitude (30' +/-)
33 35 10.0	117 41 21.9

Description:

DESCRIBED BY OCS 2003 - FOUND 3 3/4" OCS ALUMINUM BENCHMARK DISK STAMPED "3CC-10-83", SET IN THE SOUTHEASTERLY CORNER OF A 4 FT. BY 15 FT. CONCRETE CATCH BASIN. MONUMENT IS LOCATED IN THE NORTHEASTERLY CORNER OF THE INTERSECTION OF LA PAZ ROAD AND GALLUP CIRCLE, 68 FT. NORTHERLY OF THE CENTERLINE OF GALLUP AND 45 FT. EASTERLY OF THE CENTERLINE OF LA PAZ. MONUMENT IS SET LEVEL WITH THE SIDEWALK.

