

Designation: 3D-114-71

Date Destroyed:

Date Revised: 8/14/2017

GPS #:

OCS Index Map: Q08-14


Page/Grid: 801/E-7

City / Location: Unin., Orange Co.

Line #/SSN: 354/0350

Established By: OCS 1971

Monument Type: Orange County Surveyor's 3 3/4"
Aluminum Disk

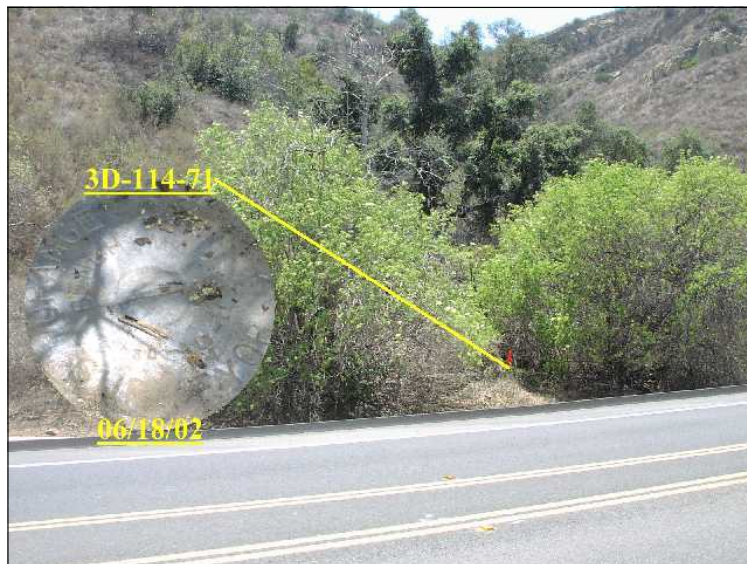

NAVD88 (ft)	NGVD29 (ft)	Year Leveled
824.899	822.496	2017
824.946	822.543	1991

For Reconnaissance Only!	
Latitude (30' +/-)	Longitude (30' +/-)
33 46 02.85	117 43 01.05

Description:

DESCRIBED BY OCS 2002 - FOUND 3 3/4" OCS ALUMINUM BENCHMARK DISK STAMPED "3D-114-71", SET IN THE TOP OF A 6 IN. BY 6 IN. CONCRETE POST. MONUMENT IS LOCATED ALONG THE SOUTHERLY SIDE OF SANTIAGO CANYON ROAD, 3.1 MILES NORTHWESTERLY OF THE CENTERLINE OF SILVERADO CANYON ROAD, 48 FT. SOUTHWESTERLY OF THE CENTERLINE OF SANTIAGO CANYON ROAD AND 320 FT. NORTHWESTERLY OF THE CENTERLINE OF THE ENTRANCE TO IRVINE LAKE. MONUMENT IS SET LEVEL WITH THE GROUND.

