

VERTICAL CONTROL DATA SHEET O.C.S. 1995 ADJUSTMENT



Designation: 3D-127-71

Date Destroyed:

Date Revised: 7/2/2007

GPS #:


OCS Index Map: Q07-11
Page/Grid: 800/E-4
City / Location: Orange

Line #/SSN: 354/0450 Established By: OCS 1971

Monument Type: Orange County Surveyor's 3 3/4"

Aluminum Disk

NAVD88 (ft)	NGVD29 (ft)	Year Leveled
343.031	340.604	2010
343.000	340.575	1991

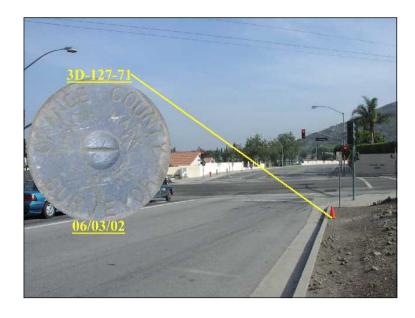

For Reconnaisance Only!		
Latitude (30' +/-)	Longitude (30' +/-)	
33 47 14.77803	117 47 44.53036	

Description:

DESCRIBED BY OCS 2002 - FOUND 3 3\4" OCS ALUMINUM BENCHMARK DISK STAMPED "3D-127-71", SET IN THE TOP OF A 6 IN. BY 6 IN. CONCRETE POST. MONUMENT IS LOCATED IN THE SOUTHEASTERLY CORNER OF THE INTERSECTION OF CHAPMAN AVENUE AND CRAWFORD CANYON ROAD, 37.5 FT. EASTERLY OF THE CENTERLINE OF CRAWFORD CANYON AND 92 FT. SOUTHERLY OF THE CENTERLINE OF CHAPMAN. MONUMENT IS SET LEVEL WITH THE SIDEWALK.

