

Designation: 3D-141-79

Date Destroyed:

Date Revised:

GPS #:

OCS Index Map: Q07-12


Page/Grid: 800/G-3

City / Location: Orange

Line #/SSN: 354/0420

Established By: OCS 1979

Monument Type: Orange County Surveyor's 3 3/4"
Aluminum Disk

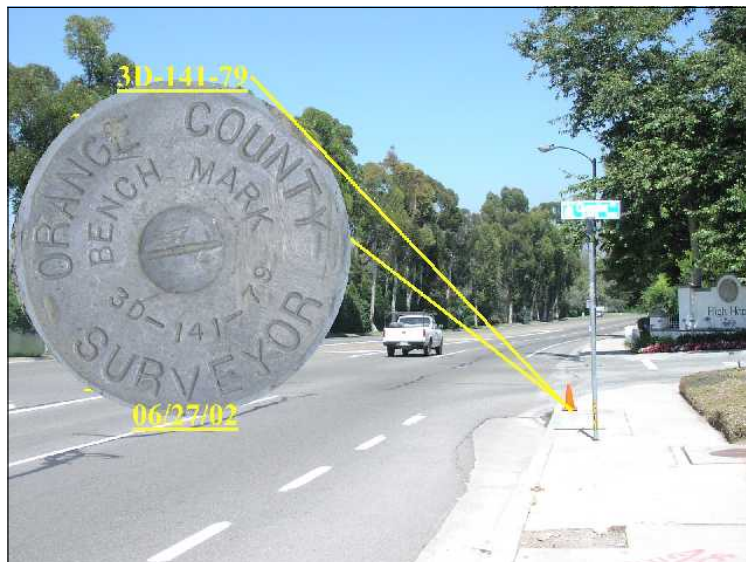

NAVD88 (ft)	NGVD29 (ft)	Year Leveled
521.129	518.707	1991

For Reconnaissance Only!	
Latitude (30' +/-)	Longitude (30' +/-)
33 47 45.38	117 46 37.71

Description:

DESCRIBED BY OCS 2002 - FOUND 3 3/4" OCS ALUMINUM BENCHMARK DISK STAMPED "3D-141-79", SET IN THE NORTHEASTERLY CORNER OF A 4 FT. BY 15 FT. CONCRETE CATCH BASIN. MONUMENT IS LOCATED IN THE SOUTHWESTERLY CORNER OF THE INTERSECTION OF CHAPMAN AVENUE AND CHANDLER RANCH ROAD/BRAMBLES WAY.

