

Designation: 3E-108-86

Date Destroyed:

Date Revised: 4/9/2014

GPS #:

OCS Index Map: Q12-08


Page/Grid: 861/A-1

City / Location: Irvine

Line #/SSN: 355/0230

Established By: OCS 1986

Monument Type: Orange County Surveyor's 3 3/4"
Aluminum Disk

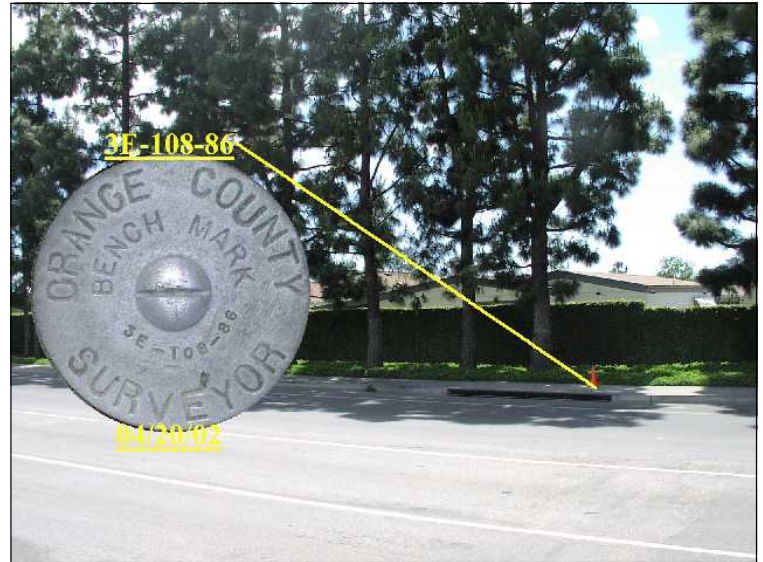

NAVD88 (ft)	NGVD29 (ft)	Year Leveled
241.203	238.801	2014
241.258	238.861	1991

For Reconnaissance Only!	
Latitude (30' +/-)	Longitude (30' +/-)
33 42 34.06	117 45 15.17

Description:

DESCRIBED BY OCS 2002 - FOUND 3 3/4" OCS ALUMINUM BENCHMARK DISK STAMPED "3E-108-86", SET IN THE CENTER OF A 5 FT. BY 15 FT. CONCRETE CATCH BASIN. MONUMENT IS LOCATED IN THE SOUTHERLY CORNER OF THE INTERSECTION OF IRVINE BOULEVARD AND THE GROVES, 144 FT. SOUTHEASTERLY OF THE CENTERLINE OF THE GROVES AND 67 FT. SOUTHWESTERLY OF THE CENTERLINE OF IRVINE. MONUMENT IS SET LEVEL WITH THE SIDEWALK.

