

Designation: 3E-110-86

Date Destroyed:

Date Revised: 4/9/2014

GPS #: 1511

OCS Index Map: Q12-04


Page/Grid: 830/H-6

City / Location: Irvine

Line #/SSN: 355/0250

Established By: OCS 1986

Monument Type: Orange County Surveyor's 3 3/4"
Aluminum Disk

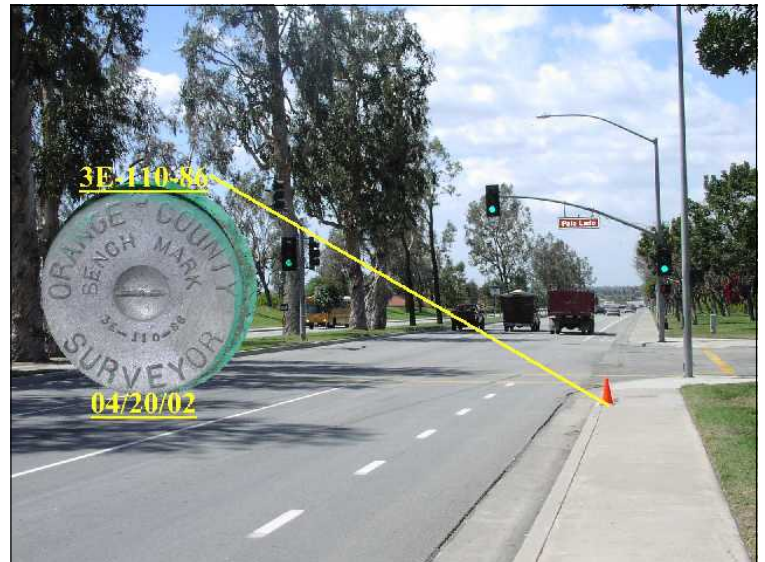

NAVD88 (ft)	NGVD29 (ft)	Year Levelled
178.234	175.829	2014
178.373	175.971	1991

For Reconnaissance Only!	
Latitude (30' +/-)	Longitude (30' +/-)
33 43 07.76599	117 46 01.14365

Description:

DESCRIBED BY OCS 2002 - FOUND 3 3/4" OCS ALUMINUM BENCHMARK DISK STAMPED "3E-110-86", SET IN THE SOUTHWESTERLY CORNER OF A 5 FT. BY 8 FT. CONCRETE CATCH BASIN. MONUMENT IS LOCATED IN THE EASTERLY CORNER OF THE INTERSECTION OF IRVINE BOULEVARD AND PALO LADO STREET, 54 FT. NORTHEASTERLY OF THE CENTERLINE OF IRVINE AND 74 FT. SOUTHEASTERLY OF THE CENTERLINE OF PALO LADO STREET. MONUMENT IS SET LEVEL WITH THE SIDEWALK.

