

Designation: 3G-38-91

Date Destroyed:

Date Revised: 3/5/2002

GPS #:

OCS Index Map: Q12-04


Page/Grid: 830/G-3

City / Location: Tustin

Line #/SSN: 357/0080

Established By: OCS 1991

Monument Type: Orange County Surveyor's 3 3/4"
Aluminum Disk

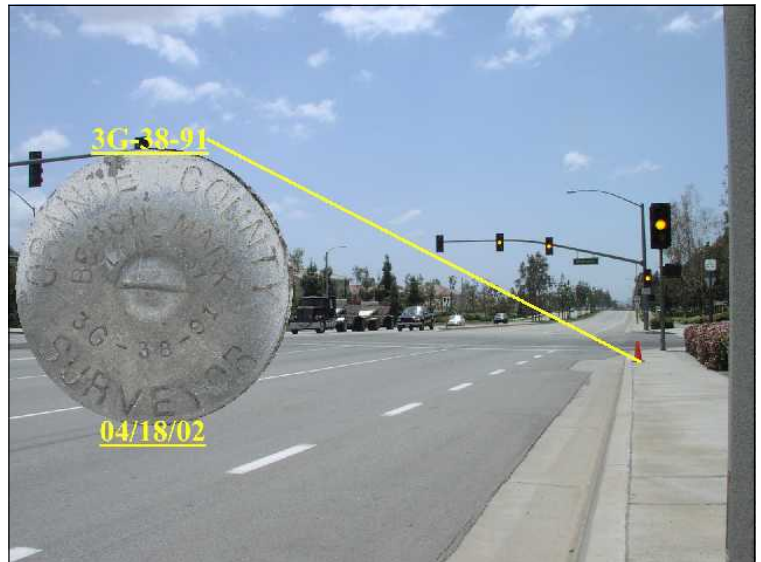

NAVD88 (ft)	NGVD29 (ft)	Year Leveled
196.805	194.393	1991

For Reconnaissance Only!	
Latitude (30' +/-)	Longitude (30' +/-)
33 44 27.03	117 46 28.30

Description:

DESCRIBED BY OCS 2002 - FOUND 3 3/4" OCS ALUMINUM BENCHMARK DISK STAMPED "3G-38-91", SET IN THE NORTHEASTERLY CORNER OF A 4 FT. BY 14 FT. CONCRETE CATCH BASIN. MONUMENT IS LOCATED IN THE NORTHWESTERLY CORNER OF THE INTERSECTION OF CHAMPION WAY AND JAMBOREE ROAD, 85 FT. NORTHERLY OF THE CENTERLINE OF CHAMPION AND 55 FT. WESTERLY OF THE CENTERLINE OF JAMBOREE. MONUMENT IS SET LEVEL WITH THE SIDEWALK.

