

Designation: 3H-15-81

Date Destroyed:

Date Revised: 4/7/2004

GPS #:

OCS Index Map: Q12-07


Page/Grid: 860/F-1

City / Location: Irvine

Line #/SSN: 358/0050

Established By: OCS 1981

Monument Type: Orange County Surveyor's 3 3/4"
Aluminum Disk

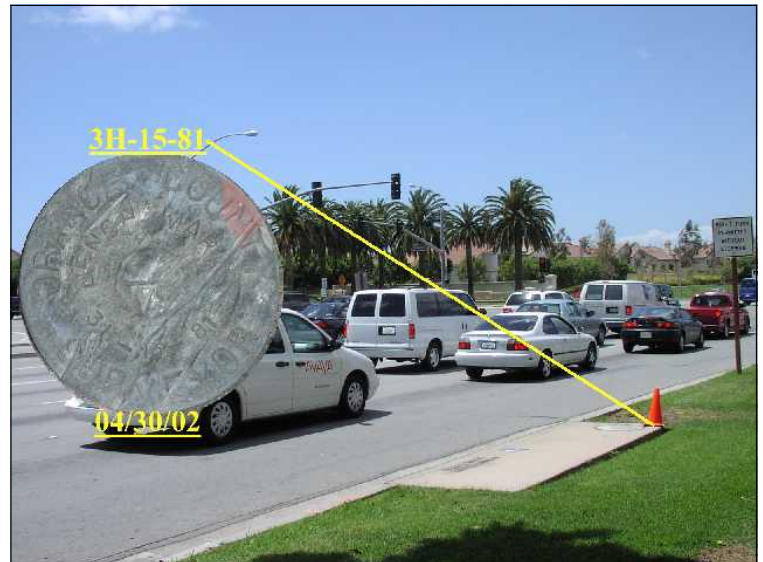

NAVD88 (ft)	NGVD29 (ft)	Year Levelled
70.889	68.490	2003
70.856	68.455	1991

For Reconnaissance Only!	
Latitude (30' +/-)	Longitude (30' +/-)
33 41 36.17	117 47 53.95

Description:

DESCRIBED BY OCS 2002 - FOUND 3 3/4" OCS ALUMINUM BENCHMARK DISK STAMPED "3H-15-81", SET IN THE NORTHERLY CORNER OF A 4.3 FT. BY 15 FT. CONCRETE CATCH BASIN. MONUMENT IS LOCATED IN THE EASTERLY CORNER OF THE INTERSECTION OF CULVER DRIVE AND IRVINE CENTER DRIVE, 167.4 FT. SOUTHEASTERLY OF THE CENTERLINE OF CULVER DRIVE AND 56.6 FT. NORTHEASTERLY OF THE CENTERLINE OF IRVINE CENTER DRIVE. MONUMENT IS SET LEVEL WITH THE SIDEWALK.

