

Designation: 3JJ-20-90

Date Destroyed:

Date Revised: 4/7/2004

GPS #:

OCS Index Map: Q13-11


Page/Grid: 862/C-6

City / Location: Portola Hills

Line #/SSN: 346/0110

Established By: OCS 1990

Monument Type: Orange County Surveyor's 3 3/4"
Aluminum Disk

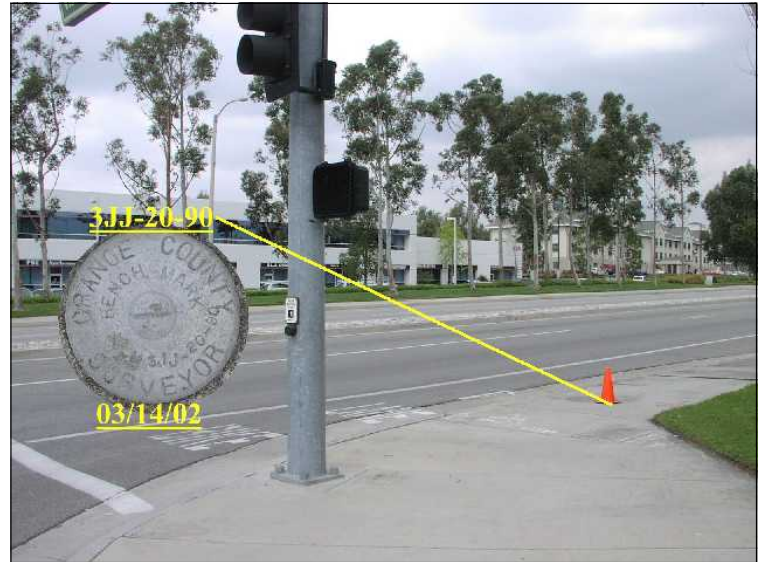

NAVD88 (ft)	NGVD29 (ft)	Year Leveled
731.858	729.494	2004
731.926	729.562	1990

For Reconnaissance Only!	
Latitude (30' +/-)	Longitude (30' +/-)
33 39 59.09	117 39 47.03

Description:

DESCRIBED BY OCS 2002 - FOUND 3 3/4" OCS ALUMINUM BENCHMARK DISK STAMPED "3JJ-20-90", SET IN THE NORTHEAST CORNER OF AN 11 FT. BY 4 FT. CONCRETE CATCH BASIN. MONUMENT IS LOCATED IN THE NORTHEAST CORNER OF THE INTERSECTION OF LAKE FOREST DRIVE AND VISTA TERRACE, 47 FT. EASTERLY OF THE CENTERLINE OF LAKE FOREST DRIVE AND 50 FT. NORTHERLY OF THE CENTERLINE OF VISTA TERRACE. MONUMENT IS SET LEVEL WITH THE SIDEWALK.

