

Designation: 3L-30-71

Date Destroyed:

Date Revised: 7/2/2007

GPS #:

OCS Index Map: Q07-10


Page/Grid: 800/A-1

City / Location: Orange

Line #/SSN: 361/0040

Established By: OCS 1971

Monument Type: Orange County Surveyor's 3 3/4"
Aluminum Disk

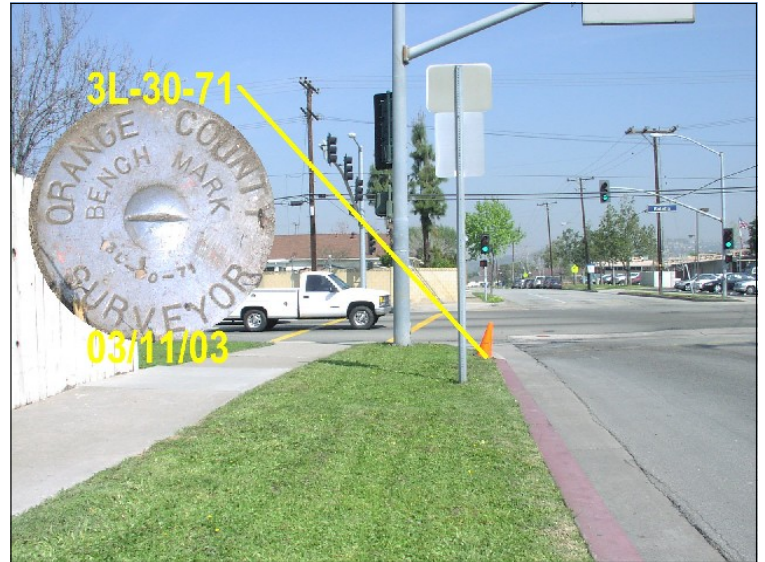

NAVD88 (ft)	NGVD29 (ft)	Year Leveled
281.723	279.304	2010
281.723	279.304	1991

For Reconnaissance Only!	
Latitude (30' +/-)	Longitude (30' +/-)
33 48 36.48348	117 49 37.61779

Description:

DESCRIBED BY OCS 2003 - FOUND 3 3/4" OCS ALUMINUM BENCHMARK DISK STAMPED "3L-30-71", SET IN THE TOP OF A 6 IN. BY 6 IN. CONCRETE POST. MONUMENT IS LOCATED IN THE SOUTHWESTERLY CORNER OF THE INTERSECTION OF KATELLA AVENUE AND HANDY STREET, 80.8 SOUTHERLY OF THE CENTERLINE MEDIAN ALONG KATELLA, 18.3 FT. WESTERLY OF THE CENTERLINE OF HANDY AND 1 FT. WESTERLY OF THE SOUTH/SOUTHWESTERLY CURB RETURN. MONUMENT IS SET LEVEL WITH THE TOP OF THE CURB.

