

Designation: 3L-52-92

Date Destroyed:

Date Revised:

GPS #:

OCS Index Map: Q07-07


Page/Grid: 770/F-7

City / Location: Orange

Line #/SSN: 386/0030

Established By: OCS 1992

Monument Type: Orange County Surveyor's 3 3/4"
Aluminum Disk

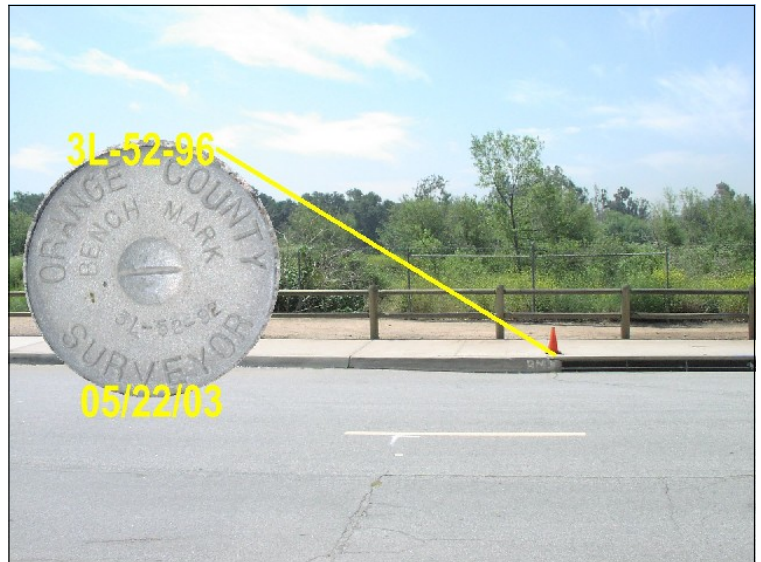

NAVD88 (ft)	NGVD29 (ft)	Year Levelled
426.331	423.911	1992

For Reconnaissance Only!	
Latitude (30' +/-)	Longitude (30' +/-)
33 49 06.43	117 47 04.20

Description:

DESCRIBED BY OCS 2003 - FOUND 3 3/4" OCS ALUMINUM BENCHMARK DISK STAMPED "3L-52-92", SET NORTHEASTERLY CORNER OF A 4 FT. BY 22 FT. CONCRETE CATCH BASIN. MONUMENT IS LOCATED ALONG THE SOUTHERLY SIDE OF MABURY STREET, 20 FT. SOUTHERLY OF THE CENTERLINE OF MABURY AND 0.2 MILES EASTERLY OF THE CENTERLINE OF YELLOWSTONE BOULEVARD. MONUMENT IS SET LEVEL WITH THE SIDEWALK.

