

Designation: 3M-35-04

Date Destroyed:

Date Revised: 4/7/2004

GPS #:

OCS Index Map: Q12-14


Page/Grid: 890/A-4

City / Location: Irvine

Line #/SSN: 362/0200

Established By: OCS 2004

Monument Type: Orange County Surveyor's 3 3/4"
Aluminum Disk

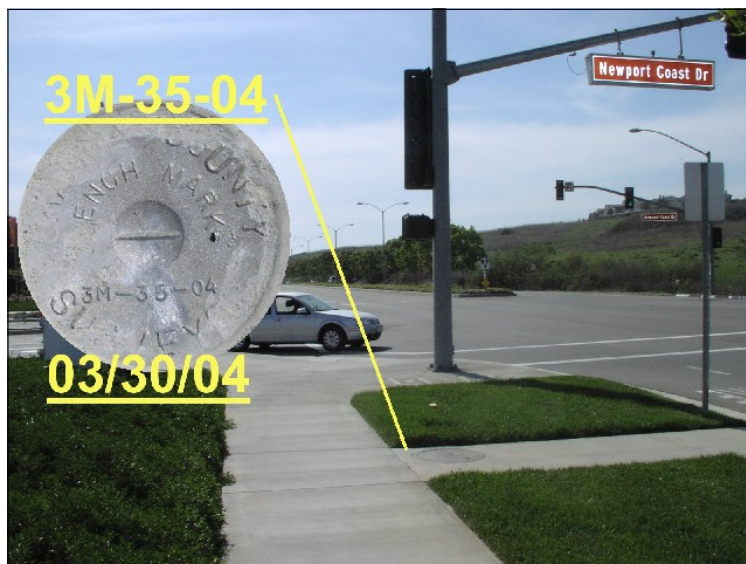

NAVD88 (ft)	NGVD29 (ft)	Year Leveled
208.807	206.441	2004

For Reconnaissance Only!	
Latitude (30' +/-)	Longitude (30' +/-)
33 37 59.62	117 50 07.67

Description:

DESCRIBED BY OCS 2004 - FOUND 3 3/4" OCS ALUMINUM BENCHMARK DISK STAMPED "3M-35-04", SET IN THE SOUTHWESTERLY CORNER OF A 15 FT. BY 13 FT. BY 4.5 FT. "L" SHAPED CONCRETE CATCH BASIN. MONUMENT IS SET IN THE SOUTHEASTERLY CORNER OF THE INTERSECTION OF NEWPORT COAST DRIVE AND BONITA CANYON ROAD, 78 FT. EASTERLY OF THE CENTERLINE OF NEWPORT COAST AND 52 FT. SOUTHERLY OF THE CENTERLINE OF BONITA CANYON ROAD. MONUMENT IS SET LEVEL WITH THE SIDEWALK.

