

Designation: 3MM-5-78R86

Date Destroyed:

Date Revised:

GPS #:

OCS Index Map: Q20-02


Page/Grid: 971/F-4

City / Location: Dana Point

Line #/SSN: 344/0060

Established By: OCS 1986

Monument Type: Orange County Surveyor's 3 3/4"
Aluminum Disk

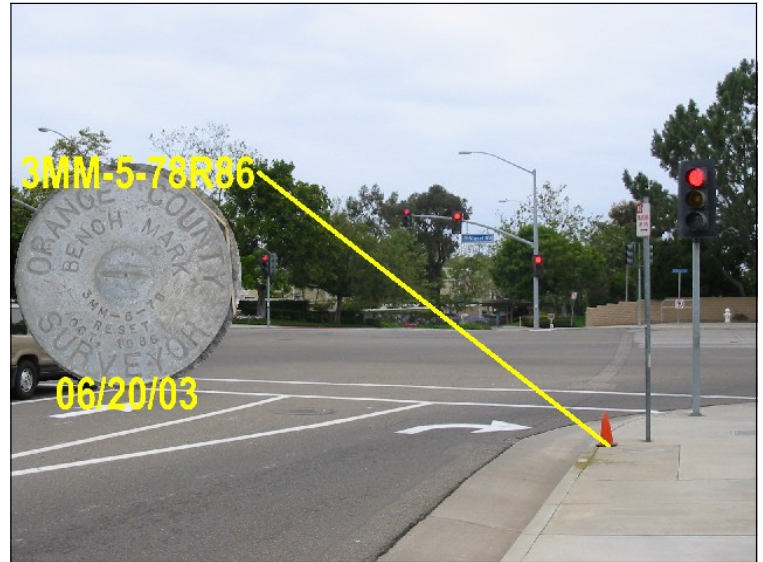

NAVD88 (ft)	NGVD29 (ft)	Year Leveled
169.256	166.948	1991

For Reconnaissance Only!	
Latitude (30' +/-)	Longitude (30' +/-)
33 28 46.02	117 42 48.70

Description:

DESCRIBED BY OCS 2003 - FOUND 3 3/4" OCS ALUMINUM BENCHMARK DISK STAMPED "3MM-5-78R86", SET IN THE SOUTHWESTERLY CORNER OF A 4 FT. BY 11 FT. CONCRETE CATCH BASIN. MONUMENT IS LOCATED IN THE NORTHEASTERLY CORNER OF THE INTERSECTION OF NIGUEL ROAD AND STONEHILL DRIVE, 42 FT. NORTHERLY OF THE CENTERLINE OF STONEHILL AND 82 FT. EASTERLY OF THE CENTERLINE OF NIGUEL. MONUMENT IS SET LEVEL WITH THE SIDEWALK.

