

Designation: 3P-24-68

Date Destroyed:

Date Revised:

GPS #:

OCS Index Map: Q20-07


Page/Grid: 972/A-6

City / Location: Dana Point

Line #/SSN: 400/0180

Established By: OCS 1968

Monument Type: Orange County Surveyor's 3 3/4"
Aluminum Disk

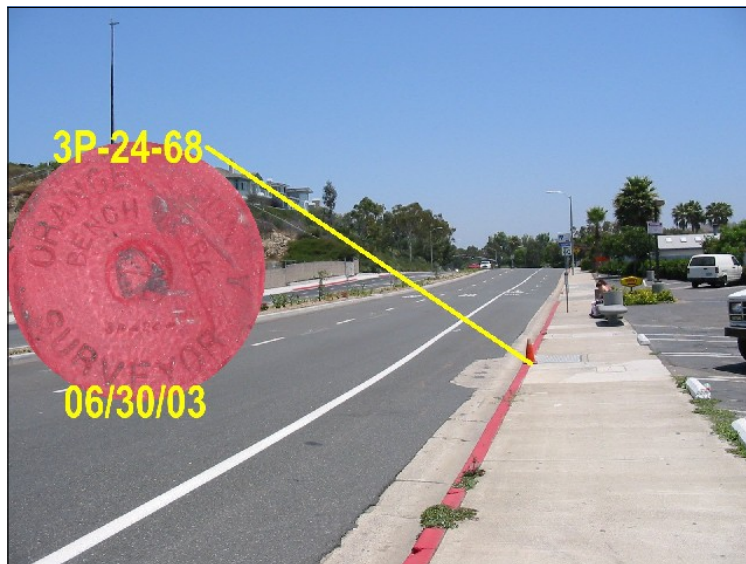

NAVD88 (ft)	NGVD29 (ft)	Year Leveled
15.945	13.652	2004
15.945	13.652	1989

For Reconnaissance Only!	
Latitude (30' +/-)	Longitude (30' +/-)
33 27 55.96	117 41 12.48

Description:

DESCRIBED BY OCS 2003 - FOUND 3 3/4" OCS ALUMINUM BENCHMARK DISK STAMPED "3P-24-68", SET IN THE SOUTHWESTERLY CORNER OF A 4 FT. BY 4 FT. CONCRETE CATCH BASIN. MONUMENT IS LOCATED IN THE NORTHEASTERLY CORNER OF THE INTERSECTION OF DEL OBISPO DRIVE AND PACIFIC COAST HIGHWAY, 38.1 FT. EASTERLY OF THE CENTERLINE OF DEL OBISPO AND 245.1 FT. NORTHERLY OF THE CENTERLINE OF PCH. MONUMENT IS SET LEVEL WITH THE SIDEWALK.

