

## Designation: 3PP-20-83

Date Destroyed:

Date Revised:

GPS #:

OCS Index Map: Q17-04


Page/Grid: 892/D-6

City / Location: Mission Viejo

Line #/SSN: 381/0010

Established By: OCS 1983

Monument Type: Orange County Surveyor's 3 3/4"  
Aluminum Disk

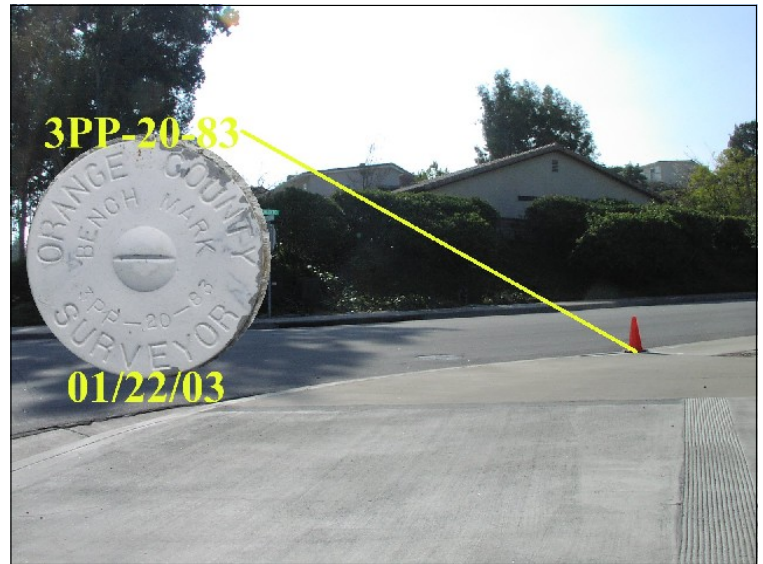

NAVD88 (ft)	NGVD29 (ft)	Year Leveled
576.899	574.548	1989

For Reconnaissance Only!	
Latitude (30' +/-)	Longitude (30' +/-)
33 37 07.03	117 39 03.24

### Description:

DESCRIBED BY OCS 2003 - FOUND 3 3/4" OCS ALUMINUM BENCHMARK DISK STAMPED "3PP-20-83", SET IN THE SOUTHEASTERLY CORNER OF A 5 FT. BY 22 FT. CONCRETE CATCH BASIN. MONUMENT IS LOCATED IN THE NORTHWESTERLY CORNER OF THE INTERSECTION OF MARGUERITE PARKWAY AND CALIXTO STREET, 21 FT. NORTHERLY OF THE CENTERLINE OF CALIXTO AND 20 FT. WESTERLY OF THE CENTERLINE OF MARGUERITE PARKWAY. MONUMENT IS SET LEVEL WITH THE SIDEWALK.

