Designation: 3PP-3-81

Date Destroyed:

Date Revised:

GPS #:

OCS Index Map: Q13-16

Page/Grid: 892/E-5

City / Location: Mission Viejo

Line #/SSN: 381/0040

Established By: OCS 1981

Monument Type: Orange County Surveyor's 3 3/4" Aluminum Disk

NAVD88 (ft)	NGVD29 (ft)	Year Leveled
676.110	673.759	1989

For Reconnaisance Only!	
Latitude (30' +/-)	Longitude (30' +/-)
33 37 28.43	117 38 27.56

Description:
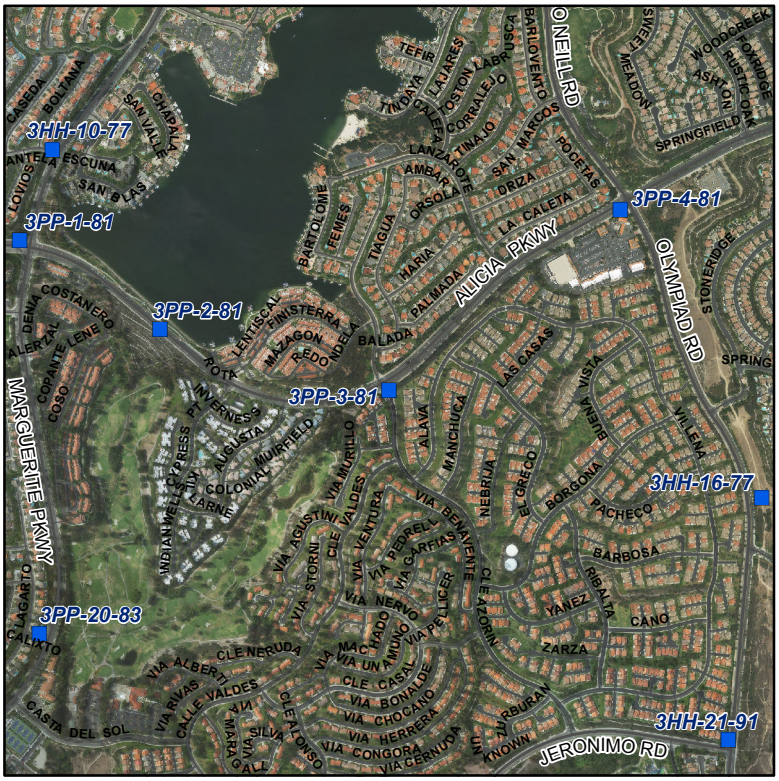
DESCRIBED BY OCS 2002 - FOUND 3 3\4" OCS ALUMINUM BENCHMARK DISK STAMPED "3PP-3-81", SET IN THE NORTHEASTERLY CORNER OF A 5 FT. BY 15 FT. CONCRETE CATCH BASIN. MONUMENT IS LOCATED IN THE SOUTHEASTERLY CORNER OF THE INTERSECTION OF CALLE AZORIN AND ALICIA PARKWAY, 36 FT. EASTERLY OF THE CENTERLINE OF CALLE AZORIN AND 72 FT. SOUTHERLY OF THE CENTERLINE OF ALICIA. MONUMENT IS SET LEVEL WITH THE SIDEWALK.