

Designation: 3X-48-83

Date Destroyed:

Date Revised: 4/9/2014

GPS #:

OCS Index Map: Q17-02


Page/Grid: 921/F-1

City / Location: Leisure World

Line #/SSN: 371/0110

Established By: OCS 1983

Monument Type: Orange County Surveyor's 3 3/4"
Aluminum Disk

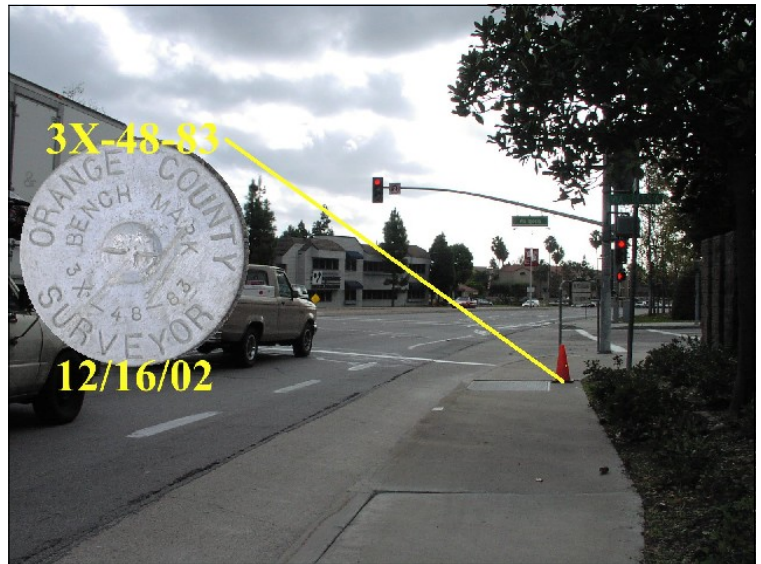

NAVD88 (ft)	NGVD29 (ft)	Year Leveled
332.937	330.584	2014
332.937	330.584	1991

For Reconnaissance Only!	
Latitude (30' +/-)	Longitude (30' +/-)
33 36 04.22	117 43 01.70

Description:

DESCRIBED BY OCS 2002 - FOUND 3 3/4" OCS ALUMINUM BENCHMARK DISK STAMPED "3X-48-83", SET IN THE SOUTHWESTERLY CORNER OF A 5 FT. BY 22 FT. CONCRETE CATCH BASIN. MONUMENT IS LOCATED IN THE NORTHWESTERLY CORNER OF THE INTERSECTION OF VIA IGLESIA AND MOULTON PARKWAY, 58.3 FT. NORTHERLY OF THE CENTERLINE OF VIA IGLESIA, 71.2 FT. WESTERLY OF THE CENTERLINE OF MOULTON PARKWAY AND 4.2 FT. WESTERLY OF THE CURB FACE ALONG MOULTON. MONUMENT IS SET LEVEL WITH THE SIDEWALK.

