

## Designation: 3X-59-91

Date Destroyed:

Date Revised:

GPS #:

OCS Index Map: Q17-10


Page/Grid: 951/F-3

City / Location: Laguna Niguel

Line #/SSN: 371/0230

Established By: OCS 1991

Monument Type: Orange County Surveyor's 3 3/4"  
Aluminum Disk

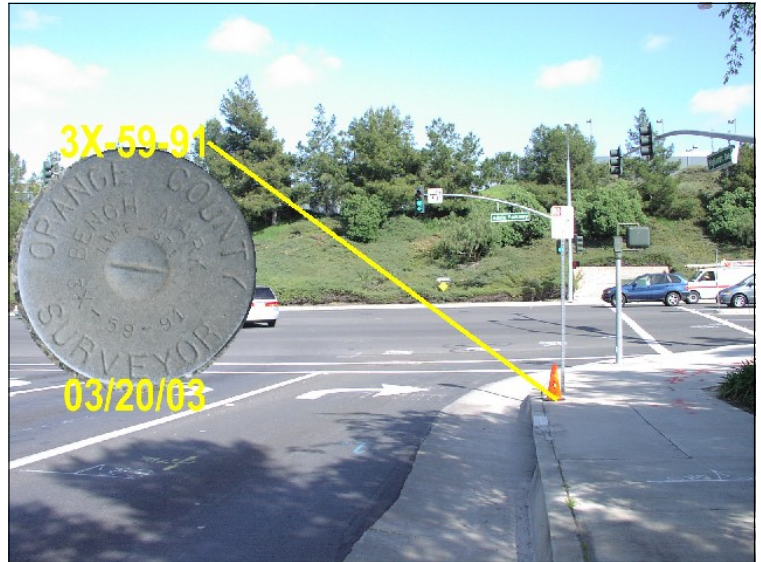

NAVD88 (ft)	NGVD29 (ft)	Year Leveled
250.167	247.835	1991

For Reconnaissance Only!	
Latitude (30' +/-)	Longitude (30' +/-)
33 32 29.94	117 42 54.61

### Description:

DESCRIBED BY OCS 2003 - FOUND 3 3/4" OCS ALUMINUM BENCHMARK DISK STAMPED "3X-59-91", SET IN THE NORTHEASTERLY CORNER OF A 4 FT. BY 14 FT. CONCRETE CATCH BASIN. MONUMENT IS LOCATED IN THE SOUTHWESTERLY CORNER OF THE INTERSECTION OF HIGHLANDS AVENUE AND ALICIA PARKWAY, 90 FT. WESTERLY OF THE CENTERLINE OF ALICIA PARKWAY AND 39 FT. SOUTHERLY OF THE CENTERLINE OF HIGHLANDS AVENUE. MONUMENT IS SET LEVEL WITH THE SIDEWALK.

