

Designation: 3X-63-04

Date Destroyed: **5/21/2013**

Date Revised: 5/21/2013

GPS #:

OCS Index Map: Q13-13


Page/Grid: 891/C-4

City / Location: Irvine

Line #/SSN: 371/0270

Established By: OCS 2004

Monument Type: Orange County Surveyor's 3 3/4"
Aluminum Disk

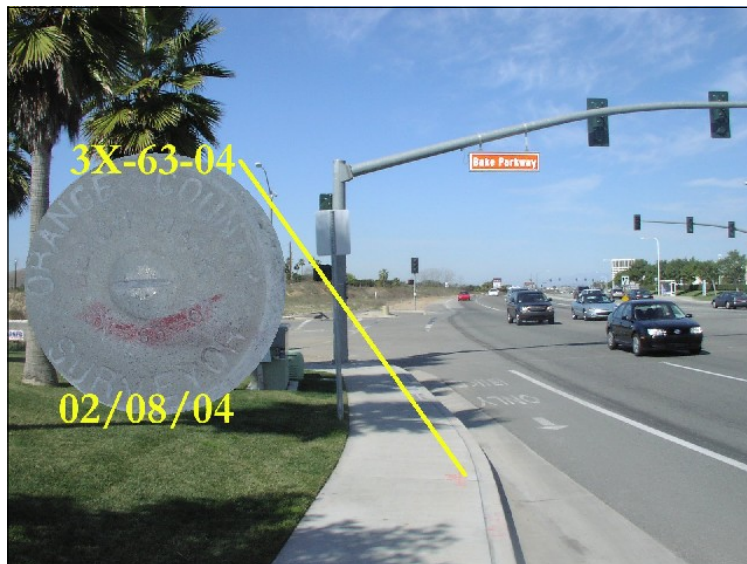

NAVD88 (ft)	NGVD29 (ft)	Year Leveled
234.449	232.081	2004

For Reconnaissance Only!	
Latitude (30' +/-)	Longitude (30' +/-)
33 38 14.15	117 44 25.89

Description:

REPORTED DESTROYED (SEE DATE IN DESTROYED BOX) - ORIGINAL DESCRIPTION BEING: DESCRIBED BY OCS 2004 - FOUND 3 3/4" OCS ALUMINUM BENCHMARK DISK STAMPED "3X-63-04", SET IN THE NORTHERLY CORNER OF A 5 FT. BY 11 FT. CONCRETE CATCH BASIN. MONUMENT IS LOCATED IN THE SOUTHERLY CORNER OF THE INTERSECTION OF IRVINE CENTER DRIVE AND BAKE PARKWAY, 96.5 FT. SOUTHEASTERLY OF THE CENTERLINE OF BAKE PARKWAY AND 54 FT. SOUTHWESTERLY OF THE CENTERLINE OF IRVINE CENTER DRIVE. MONUMENT IS SET LEVEL WITH THE SIDEWALK.

NO
LOCATION
MAP