

## Designation: 404-13-68

Date Destroyed: **3/6/2006**

Date Revised: 3/18/1999

GPS #:

OCS Index Map: Q06-04


Page/Grid: 739/C-7

City / Location: Fullerton

Line #/SSN: 404/0140

Established By: OCS 1968

Monument Type: Orange County Surveyor's 3 3/4"  
Aluminum Disk

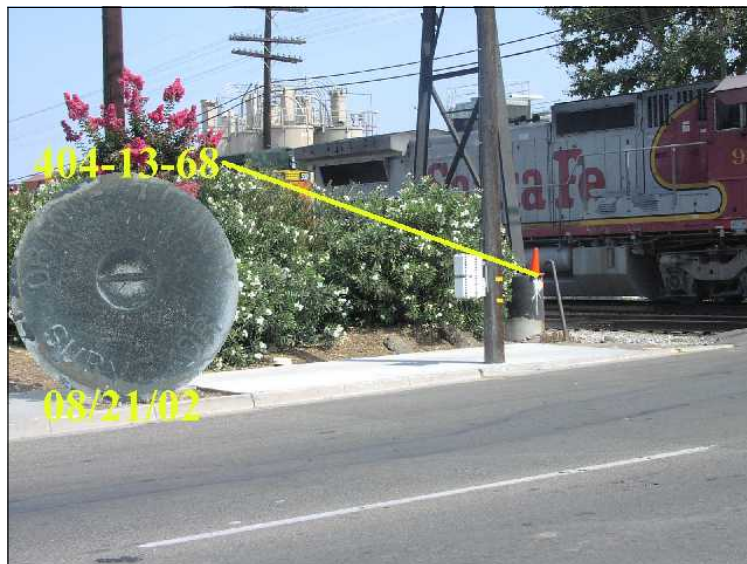

NAVD88 (ft)	NGVD29 (ft)	Year Leveled
210.119	207.704	1999
210.134	207.723	1990

For Reconnaissance Only!	
Latitude (30' +/-)	Longitude (30' +/-)
33 52 01.76	117 53 21.67

### Description:

REPORTED DESTROYED (SEE DATE IN DESTROYED BOX) - ORIGINAL DESCRIPTION BEING: DESCRIBED BY OCS 2003 - FOUND 3 3/4" OCS ALUMINUM BENCHMARK DISK STAMPED "404-13-68", SET IN THE WESTERLY SIDE OF A 3.5 FT. HIGH CONCRETE FOOTING FOR A SEMAPHORE. MONUMENT IS LOCATED IN THE NORTHEASTERLY CORNER OF THE INTERSECTION OF STATE COLLEGE BOULEVARD AND THE ATCHINSON/TOPEKA AND SANTA FE RAILWAY, 47 FT. EASTERLY OF THE CENTERLINE OF STATE COLLEGE AND 8.3 FT. NORTHERLY OF THE NORTH RAIL ALONG THE NORTHERLY TRACK. MONUMENT IS SET 3.5 FT. HIGHER THAN THE GROUND.

NO  
LOCATION  
MAP