

VERTICAL CONTROL DATA SHEET O.C.S. 1995 ADJUSTMENT



Designation: CC-13

Date Destroyed:

Date Revised:

GPS #:

OCS Index Map: Q05-07 Page/Grid: 767/A-6 City / Location: Cypress


Line #/SSN: 401/0160 Established By: USCE

Monument Type: Bronze / Brass Disk

NAVD88 (ft)	NGVD29 (ft)	Year Leveled
44.723	42.301	2005
44.826	42.349	1994

Description:

DESCRIBED BY OCS 2002 - FOUND 3 3\4" US ARMY CORPS OF ENGINEERS BRONZED DISK STAMPED "CC-13-1958", SET IN THE NORTHWEST CORNER OF A CONCRETE BRIDGE ABUTMENT. MONUMENT IS LOCATED IN THE NORTHWESTERLY CORNER OF THE INTERSECTION OF LINCOLN AVENUE AND THE COYOTE CREEK CROSSING, 40 FT. NORTHERLY OF THE CENTERLINE OF LINCOLN AVENUE AND 8 FT. EASTERLY OF THE NORTHWEST CORNER OF THE BRIDGE. MONUMENT IS SET 1.0 FT. BELOW THE ROAD.

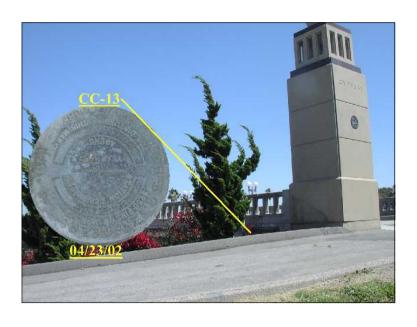

For Reconnaisance Only!		
Latitude (30' +/-)	Longitude (30' +/-)	
33 49 54.21	118 03 46.06	

