

## Designation: E-352-R65

Date Destroyed:

Date Revised:

GPS #:

OCS Index Map: Q02-12


Page/Grid: 709/B-6

City / Location: Brea

Line #/SSN: 253/0190

Established By: USC & GS 1965

Monument Type: Bronze / Brass Disk

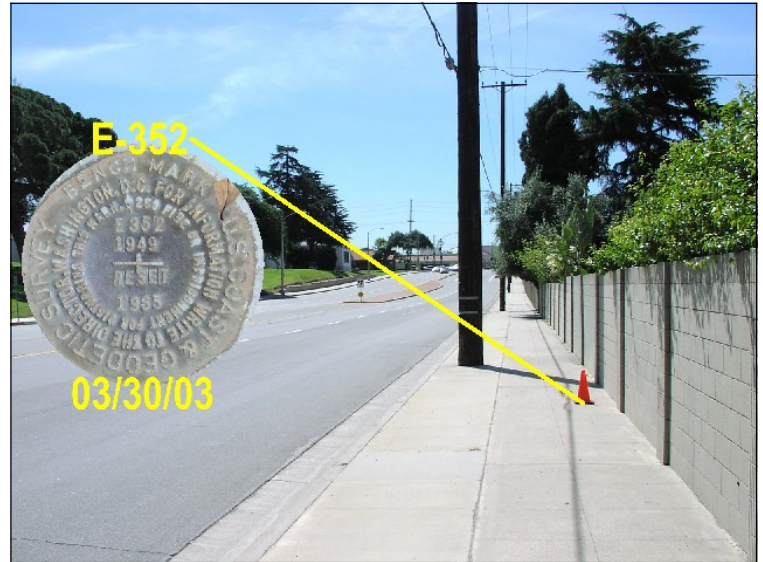

NAVD88 (ft)	NGVD29 (ft)	Year Leveled
373.888	371.471	2005
373.965	371.550	1990

For Reconnaissance Only!	
Latitude (30' +/-)	Longitude (30' +/-)
33 55 37.84	117 53 45.02

### Description:

DESCRIBED BY OCS 2003 - FOUND 3 3/4" US COAST AND GEODETIC SURVEY BRONZED DISK STAMPED "E-352-R65", SET IN THE TOP OF A CONCRETE SIDEWALK. MONUMENT IS LOCATED IN THE SOUTHWESTERLY CORNER OF THE INTERSECTION OF BREA BOULEVARD AND THE CENTERLINE OF GATEWOOD PLACE PROLONGED TO THE EAST, 52 FT. WESTERLY OF THE CENTERLINE OF BREA AND 127 FT. SOUTHERLY OF THE PROLONGATION OF THE CENTERLINE OF GATEWOOD. MONUMENT IS SET LEVEL WITH THE SIDEWALK.

