

VERTICAL CONTROL DATA SHEET O.C.S. 1995 ADJUSTMENT



Designation: HB-257-83

Date Destroyed:

Date Revised:

GPS#:

OCS Index Map: Q11-09 Page/Grid: 857/J-6


City / Location: Huntington Beach

Line #/SSN: 633/0040 Established By: OCS 1983

Monument Type: Orange County Surveyor's 3 3/4"

Aluminum Disk

NAVD88 (ft)	NGVD29 (ft)	Year Leveled
51.520	49.100	2005
51.520	49.100	1989

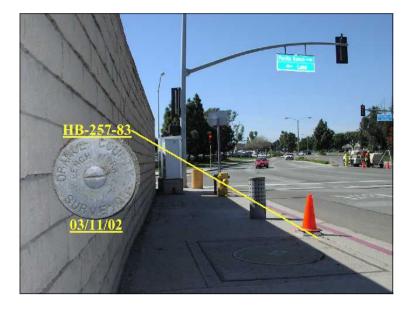

For Reconnaisance Only!		
Latitude (30' +/-)	Longitude (30' +/-)	
33 40 41.92	117 59 51.71	

Description:

DESCRIBED BY OCS 2002 - FOUND 3 3\4" OCS ALUMINUM BENCHMARK DISK STAMPED "HB-257-83", SET IN THE NORTHWEST CORNER OF A 6.4 FT. BY 5.4 FT. CONCRETE VAULT. MONUMENT IS LOCATED IN THE SOUTHEAST CORNER OF THE INTERSECTION OF LAKE STREET AND YORKTOWN AVENUE, 108.9 FT. EASTERLY OF THE CENTERLINE OF LAKE STREET AND 43.5 FT. SOUTHERLY OF THE CENTERLINE OF YORKTOWN AVENUE. MONUMENT IS SET LEVEL WITH THE SIDEWALK.

