

Designation: SA-230-70

Date Destroyed:

Date Revised:

GPS #:

OCS Index Map: Q11-04


Page/Grid: 829/E-5

City / Location: Santa Ana

Line #/SSN: 724/0050

Established By: OCS 1970

Monument Type: Orange County Surveyor's 3 3/4"
Aluminum Disk

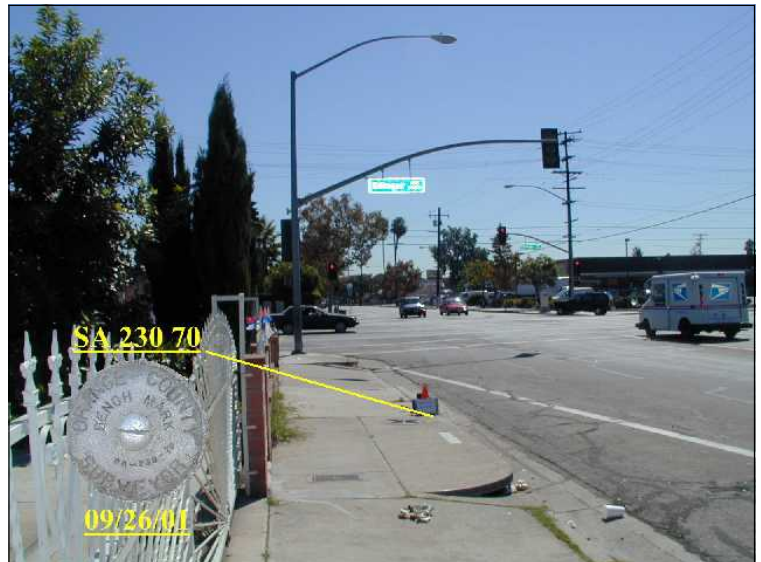

NAVD88 (ft)	NGVD29 (ft)	Year Leveled
67.406	64.995	2010
67.616	65.177	1992

For Reconnaissance Only!	
Latitude (30' +/-)	Longitude (30' +/-)
33 43 39.17	117 52 35.20

Description:

DESCRIBED BY OCS 2001 - FOUND 3 3/4" OCS ALUMINUM BENCHMARK DISK STAMPED "SA-230-70", SET IN THE SOUTHWEST CORNER OF A 4FT. BY 15.5FT. CONCRETE CATCH BASIN. MONUMENT IS LOCATED IN THE NORTHEAST CORNER OF THE INTERSECTION OF FLOWER STREET AND EDINGER AVENUE, 34FT. EASTERLY OF THE CENTERLINE OF FLOWER STREET AND 66.5FT. NORTHERLY OF THE PROLONGATION OF THE NORTH CURB OF EDINGER AVENUE. MONUMENT IS LEVEL WITH THE SIDEWALK.

