

## Designation: SA-287-75

Date Destroyed: **9/22/2003**

Date Revised:

GPS #:

OCS Index Map: Q11-08


Page/Grid: 859/D-2

City / Location: Santa Ana

Line #/SSN: 707/0040

Established By: OCS 1975

Monument Type: Orange County Surveyor's 3 3/4"  
Aluminum Disk

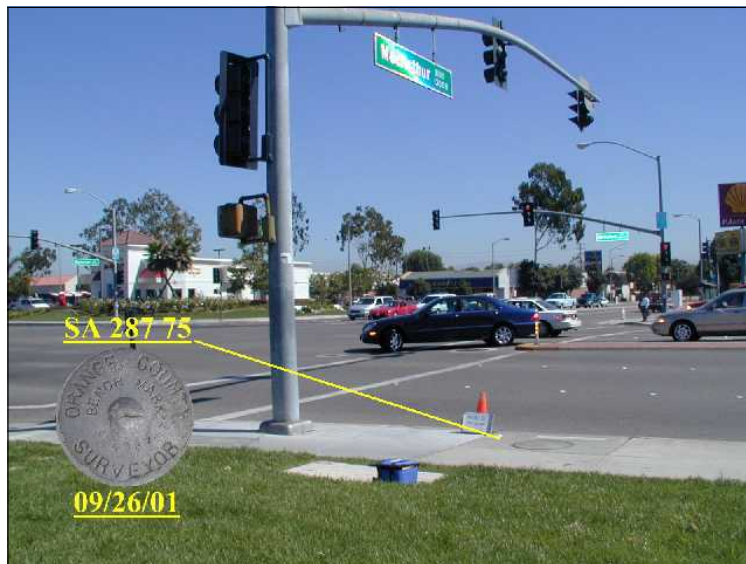

NAVD88 (ft)	NGVD29 (ft)	Year Leveled
34.449	32.030	1992

For Reconnaissance Only!	
Latitude (30' +/-)	Longitude (30' +/-)
33 41 58.93	117 53 08.42

### Description:

REPORTED DESTROYED (SEE DATE IN DESTROYED BOX) - ORIGINAL DESCRIPTION BEING: DESCRIBED BY OCS 2001 - FOUND 3 3/4" OCS ALUMINUM BENCHMARK DISK STAMPED "SA-287-75", SET IN THE NORTHEAST CORNER OF A 4FT. BY 5FT. CONCRETE CATCH BASIN. MONUMENT IS LOCATED IN THE SOUTHWEST CORNER OF THE INTERSECTION OF BRISTOL STREET AND MACARTHUR BOULEVARD, 0.3FT. SOUTHERLY OF THE SOUTH/SOUTHWEST CURB RETURN. MONUMENT IS SET LEVEL WITH SIDEWALK.

NO  
LOCATION  
MAP