

VERTICAL CONTROL DATA SHEET O.C.S. 1995 ADJUSTMENT



Designation: SA-301-82

Date Destroyed: 4/13/2004

Date Revised:

GPS #:

OCS Index Map: Q06-12 Page/Grid: 799/D-4 City / Location: Orange

Line #/SSN: 700/0030 Established By: OCS 1982

Monument Type: Orange County Surveyor's 3 3/4"


Aluminum Disk

NAVD88 (ft)	NGVD29 (ft)	Year Leveled
140.230	137.795	1990

	140.230	137.795	1990
•			

Description:

REPORTED DESTROYED (SEE DATE IN DESTROYED **BOX) - ORIGINAL DESCRIPTION BEING: DESCRIBED** BY OCS 2002 - FOUND 3 3\4" OCS ALUMINUM BENCHMARK DISK STAMPED "SA-301-82". SET IN THE NORTHWESTERLY CORNER OF AN 8 FT. BY 15 FT. CONCRETE CATCH BASIN. MONUMENT IS LOCATED IN THE NORTHEASTERLY CORNER OF THE INTERSECTION OF CHAPMAN AVENUE AND BITTERBUSH STREET, 39 FT. NORTHERLY OF THE CENTERLINE OF CHAPMAN AVENUE AND 99 FT. **EASTERLY OF THE CENTERLINE OF BITTERBUSH** STREET. MONUMENT IS SET LEVEL WITH THE SIDEWALK.

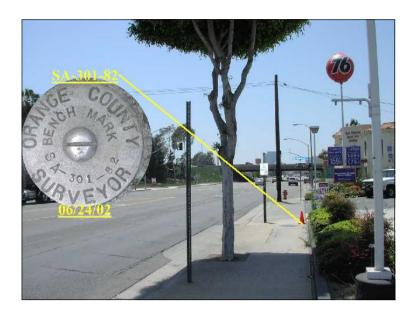

For Reconnaisance Only!			
Latitude (30' +/-)	Longitude (30' +/-)		
33 47 16.79	117 52 39.97		

