

Designation: 1A-100-68

Date Destroyed:

Date Revised:

GPS #:

OCS Index Map: Q05-10


Page/Grid: 796/J-4

City / Location: Los Alamitos

Line #/SSN: 401/0090

Established By: OCS 1968

Monument Type: Orange County Surveyor's 3 3/4"
Aluminum Disk

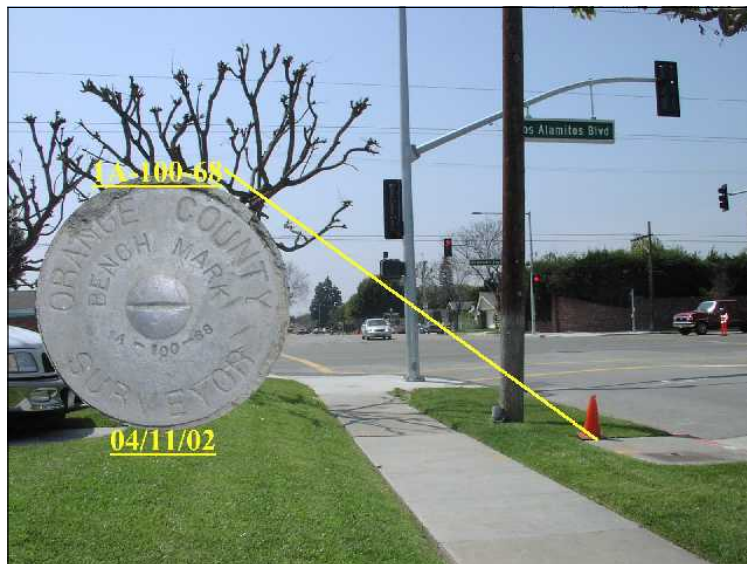

NAVD88 (ft)	NGVD29 (ft)	Year Leveled
21.153	18.734	2005
21.224	18.735	1989

For Reconnaissance Only!	
Latitude (30' +/-)	Longitude (30' +/-)
33 47 44.87	118 04 17.65

Description:

DESCRIBED BY OCS 2002 - FOUND 3 3/4" OCS ALUMINUM BENCHMARK DISK STAMPED "1A-100-68", SET IN THE SOUTHWESTERLY CORNER OF A 4 FT. BY 6 FT. CONCRETE CATCH BASIN. MONUMENT IS LOCATED IN THE SOUTHEASTERLY CORNER OF THE INTERSECTION OF ORANGEWOOD AVENUE AND LOS ALAMITOS BOULEVARD, 20 FT. SOUTHERLY OF THE CENTERLINE OF ORANGEWOOD AND 110 FT. EASTERLY OF THE CENTERLINE OF LOS ALAMITOS. MONUMENT IS SET LEVEL WITH THE SIDEWALK.

