

Designation: 1A-144-04

Date Destroyed:

Date Revised: 8/25/2005

GPS #:

OCS Index Map: Q05-14


Page/Grid: 796/J-6

City / Location: Seal Beach

Line #/SSN: 401/0840

Established By: OCS 2004

Monument Type: Orange County Surveyor's 3 3/4"
Aluminum Disk

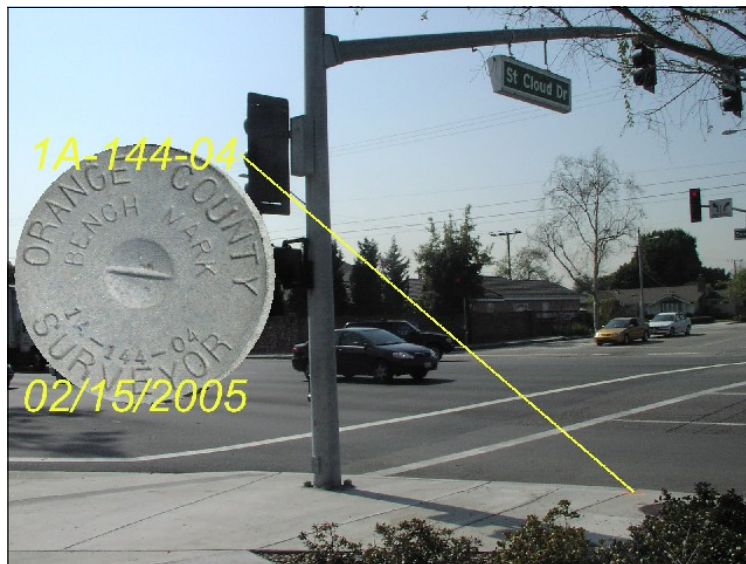

NAVD88 (ft)	NGVD29 (ft)	Year Levelled
15.370	12.952	2005

For Reconnaissance Only!	
Latitude (30' +/-)	Longitude (30' +/-)
33 46 49.78	118 04 18.67

Description:

DESCRIBED BY OCS 2005 - FOUND 3 3/4" OCS ALUMINUM BENCHMARK DISK STAMPED "1A-144-04", SET IN THE SOUTHWESTERLY CORNER OF A 4.4 FT. BY 4.4 FT. CONCRETE CATCH BASIN. MONUMENT IS LOCATED IN THE NORTHEASTERLY CORNER OF THE INTERSECTION OF SEAL BEACH BOULEVARD AND ST. CLOUD DRIVE, 44 FT. EASTERLY OF THE CENTERLINE OF SEAL BEACH BOULEVARD AND 58 FT. NORTHERLY OF THE CENTERLINE OF ST. CLOUD DR. MONUMENT IS SET LEVEL WITH THE SIDEWALK

