

Designation: 1B-103-04

Date Destroyed:

Date Revised: 4/29/2004

GPS #:

OCS Index Map: Q06-11


Page/Grid: 798/G-2

City / Location: Anaheim

Line #/SSN: 152/0280

Established By: OCS 2004

Monument Type: Orange County Surveyor's 3 3/4"
Aluminum Disk

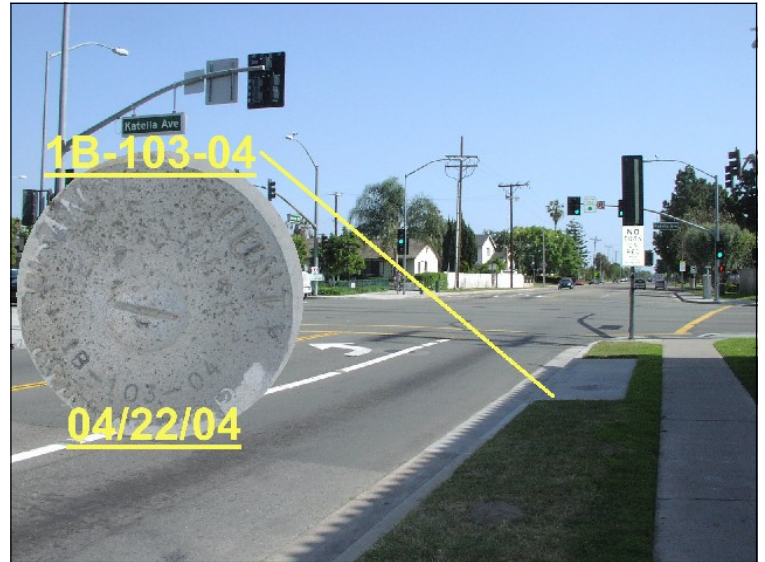

NAVD88 (ft)	NGVD29 (ft)	Year Leveled
121.661	119.244	2005
121.775	119.319	2004

For Reconnaissance Only!	
Latitude (30' +/-)	Longitude (30' +/-)
33 48 12.66	117 55 57.97

Description:

DESCRIBED BY OCS 2004 - FOUND 3 3/4" OCS ALUMINUM BENCHMARK DISK STAMPED "1B-103-04", SET IN THE NORTHEASTERLY CORNER OF A 21.5 BY 4.5 FT. CONCRETE CATCH BASIN. MONUMENT IS LOCATED IN THE NORTHWESTERLY CORNER OF THE INTERSECTION OF KATELLA AVENUE AND NINTH STREET, 105 FT. NORTHERLY OF THE CENTERLINE OF KATELLA AND 21 FT. WESTERLY OF THE CENTERLINE OF NINTH. MONUMENT IS SET LEVEL WITH THE SIDEWALK

