

## VERTICAL CONTROL DATA SHEET O.C.S. 1995 ADJUSTMENT



## Designation: 1C-124-74

**Date Destroyed:** 

**Date Revised:** 

GPS #:


OCS Index Map: Q07-13
Page/Grid: 829/F-1
City / Location: Santa Ana

Line #/SSN: 402/0590 Established By: OCS 1974

Monument Type: Orange County Surveyor's 3 3/4"

**Aluminum Disk** 

NAVD88 (ft)	NGVD29 (ft)	Year Leveled
143.426	141.005	2010
143.570	141.125	1991

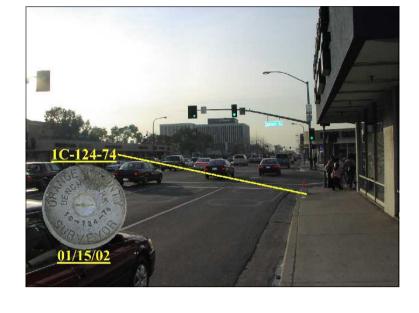

For Reconnaisance Only!		
Latitude (30' +/-)	Longitude (30' +/-)	
33 45 36.48	117 51 53.95	

## **Description:**

DESCRIBED BY OCS 2001 - FOUND 3 3\4" OCS ALUMINUM BENCHMARK DISK STAMPED "1C-124-74", SET IN THE SOUTHWEST CORNER OF A 10 FT. BY 8 FT. CONCRETE CATCH BASIN. MONUMENT IS LOCATED IN THE NORTHEASTERLY CORNER OF THE INTERSECTION OF SPURGEON STREET AND 17TH STREET, 43FT. NORTHERLY OF THE CENTERLINE OF 17TH STREET AND 55 FT. EASTERLY OF THE CENTERLINE OF SPURGEON AVENUE. MONUMENT IS SET LEVEL WITH THE SIDEWALK.

