

Designation: 1D-100-05

Date Destroyed:

Date Revised: 8/25/2005

GPS #:

OCS Index Map: Q11-07


Page/Grid: 828/G-7

City / Location: Fountain Valley

Line #/SSN: 154/0230

Established By: OCS 2005

Monument Type: Orange County Surveyor's 3 3/4"
Aluminum Disk

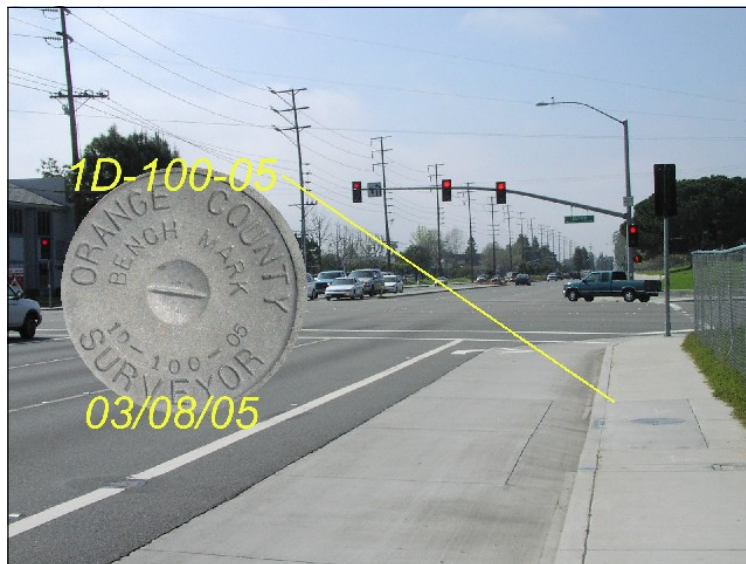

NAVD88 (ft)	NGVD29 (ft)	Year Leveled
38.341	35.930	2010
38.341	35.930	2005

For Reconnaissance Only!	
Latitude (30' +/-)	Longitude (30' +/-)
33 42 59.56	117 56 12.20

Description:

DESCRIBED BY OCS 2005 - FOUND 3 3/4" OCS ALUMINUM BENCHMARK DISK STAMPED "1D-100-05", SET IN THE SOUTHWESTERLY CORNER OF A 4.0 FT. BY 15.0 FT. CONCRETE CATCH BASIN. MONUMENT IS LOCATED IN THE NORTHEASTERLY CORNER OF THE INTERSECTION OF WARNER AVENUE AND EUCLID STREET, 122 FT. EASTERLY OF THE CENTERLINE OF EUCLID AND 58 FT. NORTHERLY OF THE CENTERLINE OF WARNER AVENUE. MONUMENT IS SET LEVEL WITH THE SIDEWALK

