

VERTICAL CONTROL DATA SHEET O.C.S. 1995 ADJUSTMENT



Designation: 1H-130-70

Date Destroyed:

Date Revised:

GPS #:

OCS Index Map: Q10-12 Page/Grid: 857/G-6


City / Location: Huntington Beach

Line #/SSN: 158/0010 Established By: OCS 1970

Monument Type: Orange County Surveyor's 3 3/4"

Aluminum Disk

NAVD88 (ft)	NGVD29 (ft)	Year Leveled
41.507	39.091	2005
41.367	38.945	1989

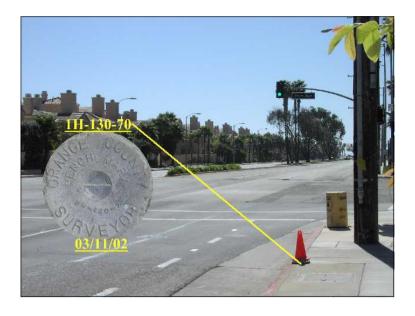

For Reconnaisance Only!		
Latitude (30' +/-)	Longitude (30' +/-)	
33 40 25.35	118 00 43.35	

Description:

DESCRIBED BY OCS 2002 - FOUND 3 3\4" OCS ALUMINUM BENCHMARK DISK STAMPED "1H-130-70", SET IN THE SOUTHEAST CORNER OF A 3.4 FT. BY 9.4 FT. CONCRETE VAULT. MONUMENT IS LOCATED IN THE NORTHERLY CORNER OF THE INTERSECTION OF PALM AVENUE AND GOLDENWEST STREET, 58.5 FT. NORTHWESTERLY OF THE CENTERLINE OF GOLDENWEST STREET AND 89 FT. NORTHEASTERLY OF THE CENTERLINE OF PALM AVENUE. MONUMENT IS SET LEVEL WITH THE SIDEWALK.

