

Designation: 1H-151-05

Date Destroyed:

Date Revised: 8/25/2005

GPS #:

OCS Index Map: Q10-12


Page/Grid: 857/H-5

City / Location: Huntington Beach

Line #/SSN: 158/0410

Established By: OCS 2005

Monument Type: Orange County Surveyor's 3 3/4"
Aluminum Disk

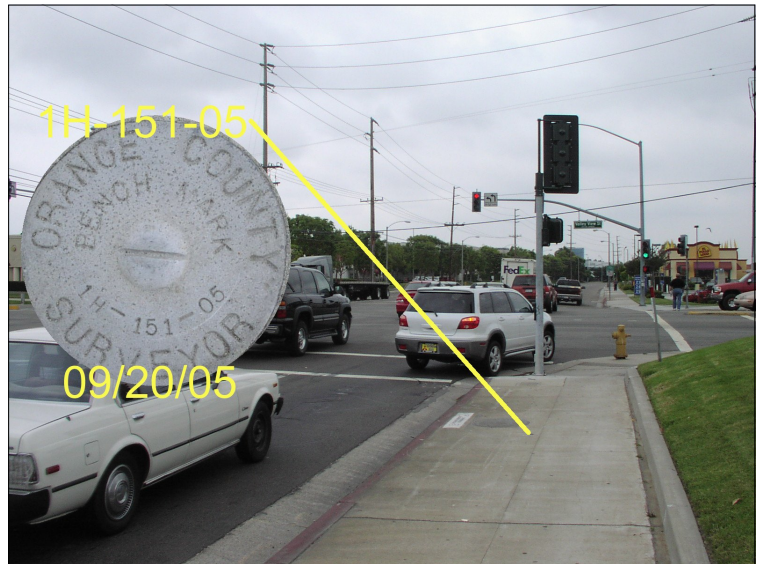

NAVD88 (ft)	NGVD29 (ft)	Year Leveled
41.963	39.543	2005

For Reconnaissance Only!	
Latitude (30' +/-)	Longitude (30' +/-)
33 48 35.78	118 01 40.38

Description:

DESCRIBED BY OCS 2005 - FOUND 3 3/4" OCS ALUMINUM BENCHMARK DISK STAMPED "1H-151-05". SET IN THE SOUTHWEST CORNER OF A 22.0 FT X 4.0 FT. CATCH BASIN. MONUMENT IS LOCATED IN THE NORTHEAST PORTION OF THE INTERSECTION OF CERRITOS AVE. AND VALLEY VIEW ST. 35 FT. NORTH OF THE CENTERLINE OF CERRITOS AVE. AND 78 FT. EASTERLY OF THE CENTERLINE OF VALLEY VIEW ST. MONUMENT IS SET LEVEL WITH THE SIDEWALK.

