

### Designation: 1J-30-68

Date Destroyed:

Date Revised:

GPS #:

OCS Index Map: Q10-07


Page/Grid: 857/D-4

City / Location: Huntington Beach

Line #/SSN: 400/0980

Established By: OCS 1968

Monument Type: Orange County Surveyor's 3 3/4"  
Aluminum Disk

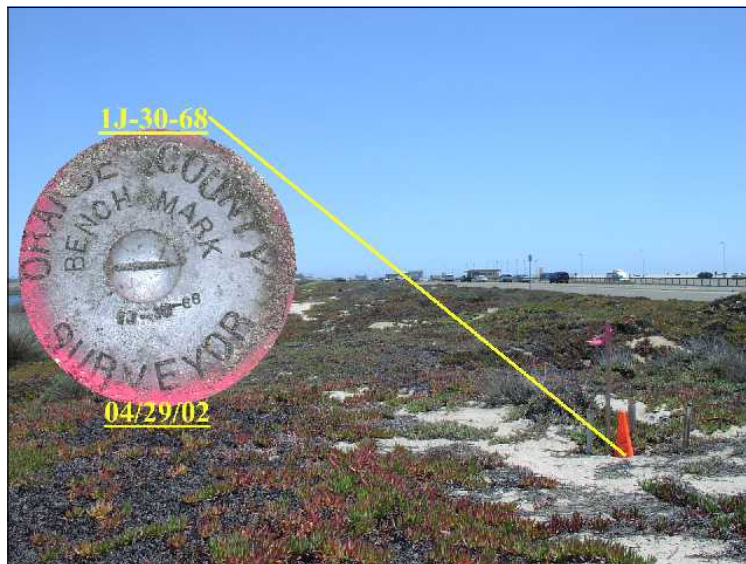

NAVD88 (ft)	NGVD29 (ft)	Year Leveled
12.317	9.901	2005
12.507	10.084	1989

For Reconnaissance Only!	
Latitude (30' +/-)	Longitude (30' +/-)
33 41 27.4	118 02 32.5

#### Description:

DESCRIBED BY OCS 2002 - FOUND 3 3/4" OCS ALUMINUM BENCHMARK DISK STAMPED "1J-30-68", SET IN THE TOP OF A 6 IN. BY 6 IN. CONCRETE POST. MONUMENT IS LOCATED ALONG THE NORTHEAST SIDE OF PACIFIC COAST HIGHWAY, 75 FT. NORTHEASTERLY OF THE CENTERLINE OF THE NORTHBOUND PCH LANES AND 1.85 MILES SOUTHWESTERLY ALONG PCH FROM THE CENTERLINE OF WARNER. MONUMENT IS SET 0.3 FT. BELOW THE GROUND.

